

C6. (Updated) Communication CW(2) – June 17, 2025 Item No. 8

VIA EMAIL

June 16, 2025

City of Vaughan, Committee of the Whole 2141 Major Mackenzie Drive Vaughan, ON L6A 1T1

Attention: City Clerks Department

Re: June 17, 2025 – Committee of the Whole Meeting Item 6.8 - City Park (HWY 27) Homes Inc. (OPA File No. OP.24.014 and ZBA File No. Z.24.031) Comments on Behalf of CP REIT Ontario Properties Limited Our File: CHO/VGN/14-01

We are the planning consultants for CP REIT Ontario Properties Limited ("Choice"), the registered landowner of lands known municipally as 8585 Highway 27, in the City of Vaughan (the "Choice Lands"), as it relates to the above-noted Applications.

BACKGROUND

The Choice lands are currently developed as a neighbourhood commercial plaza, containing a Fortinos Food Store (including seasonal garden centre) and various retail units, a standalone CIBC Bank, and surface level parking. Choice received Site Plan Approval (File No. DA.17.093), and a Minor Variance was approved (File No. 103/24), to facilitate the construction of a Shopper Drug Mart at the vacant north-west portion of the Choice lands. The lands subject to the proposed Official Plan Amendment and Zoning Bylaw Amendment (File Nos. OP.24.014 and Z.24.03) are located immediately to the north of the Choice Lands (see Figure 1, Page 2).

The existing Fortinos Food Store generates noise emissions as a part of ongoing operations. This may include overnight refrigerated storage, multiple large daytime refrigerated truck deliveries, other non-refrigerated daytime deliveries, and general noise from rooftop mechanical equipment. The Fortinos Food Store is oriented such that back of house operations, including loading, are located on the north side of the Choice lands (see Figures 2 and 3, Pages 2 and 3).

The loading associated with the future Shoppers Drug Mart is located on the north side of the proposed building and partially enclosed by a screening wall, such that these back of house operations are in close proximity to the lands subject to the proposed development (see Figures 2 and 4, Pages 2 and 3).



Figure 1: Aerial View of the Choice Lands

Location and boundaries are approximate

Figure 2: Aerial View of the Choice Lands (zoomed in)




Location and boundaries are approximate

Lands Subject to Proposed Redevelopment Derations

Figure 3: Existing Fortinos Back of House Operations

Figure 4: Future Shoppers Drug Mart Back of House Operations

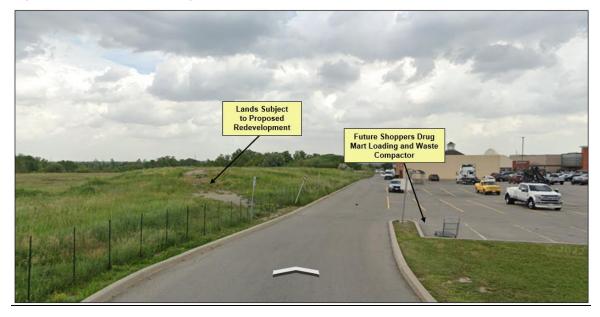

PROPOSED DEVELOPMENT

A Minister's Zoning Order ("MZO") was initially submitted in September 2024, to facilitate the proposed redevelopment of 5850 Langstaff Road (the "subject lands"). It is our understanding that the initial MZO Application was revised to an OPA (File No. OP.24.014) and a ZBA (File No. Z.24.03). We understand a Public Meeting was held on November 6, 2024, and revised OPA and ZBA applications were recently submitted to the City in March 2025.

The proposed redevelopment of the subject lands consists of three-high-density mixeduse buildings, ranging from 22 to 29 storeys. We note the proposed Building B and outdoor amenity spaces abuts the Choice Lands, where the future Shoppers Drug Mart is to be constructed.

As per Staff's Recommendation Report, it is our understanding that Staff have recommended approval of the Official Plan Amendment and Zoning By-law Amendment applications. Additionally, as per Recommendation 3, it is our understanding that Staff are recommending that the proposed development of the subject lands be designated as a

"Class 4 area pursuant to the Ministry of Environment Conservation and Parks ...". Lastly, as per Recommendation 4, it is our understanding that Staff are recommending a Holding Provision be applied to the Zoning By-law Amendment, ensuring a number of conditions to the satisfaction of the City have been met, including a revised Noise Study and implementation of approved noise mitigation measures.

PRELIMINARY COMMENTS

On behalf of Choice, we have preliminary comments as follows:

- Overall, we seek confirmation as to whether the proposed development has been adequately assessed with respect to compatibility with Choice's existing and future commercial operations. We have reviewed the Environmental Noise Feasibility Study prepared by HGC Noise and Vibration Acoustics and the Land Use Compatibility Statement prepared by Glen Schnarr & Associated Inc, included within the Official Plan Amendment and Zoning By-law Amendment applications. Based on our preliminary review, consideration of the potential noise and vibration impacts from the future Shoppers Drug Mart has not been considered. Further, we note that the existing refrigerated trucks used for the Fortino's delivery has also not been considered. We request that the proposed Shoppers Drug Mart and existing refrigerant trucks used for the Fortino's back of house operations is incorporated within the compatibility analysis, to ensure the proposed sensitive residential uses are compatible with the Choice Lands, with respect to noise and vibration.
- As per Staff Recommendation 3, we understand Staff are recommending "... the high-rise residential development for the Subject Lands be designated as a Class 4 area pursuant to the Ministry of the Environment, Conservation, and Parks Noise Guideline NPC-300...".
 - We seek clarification as to what noise source(s) surrounding the subject lands, including the aforementioned uses on the Choice lands, have resulted in the proposed development not being able to meet the permitted Class 1 area noise levels, resulting in the recommended Class 4 area designation;
 - We seek clarification as to what noise mitigation measures are being proposed in order to meet the permitted Class 4 area noise levels. We request that any necessary mitigation measures to the existing and future operations of the Choice Lands sufficiently be implemented.
- As per Staff Recommendation 4 i), we understand that a City-initiated peer review report was completed (titled Environmental Noise Feasibility Study Peer Review – Proposed Residential Development – Hwy 27 & Langstaff Road, dated May 23), and the applicant's noise study be revised (as per the City-initiated peer review report), as a condition to lift the proposed Holding Provision.
 - We have requested a copy of this report to understand what necessary revisions to the applicant's noise study the City is requiring, in order to apply to lift the proposed Holding Provision. In detail, we seek clarification if the City has requested the future and existing commercial operations of the Choice Lands be considered within the revised noise study. To date, we have not received a copy of the peer review report.
 - We seek clarification as to what noise mitigation measures the City is requesting the applicant implement, in order to apply to lift the proposed Holding Provisions.

Based on our preliminary review of available information, Choice requests that the OPA and ZBA supporting materials be revised to complete a fulsome review of potential compatibility concerns, with appropriate regard for the existing operation of the Fortinos and future Shoppers Drug Mart on the Choice Lands. Further, we request that any necessary mitigation measures are implemented to sufficiently demonstrate compatibility with the existing and future loading operations of the Choice Lands, to the proposed redevelopment. As currently proposed, Choice is of the opinion that a decision related to the proposed OPA and ZBA is premature, on the basis that compatibility with existing and approved development within the commercial development has not been sufficiently demonstrated.

We will continue to review the OPA and ZBA applications in more detail, and subject to any further submissions by the applicant, we may provide additional comments or details with respect to the comments already provided.


We would appreciate that our office continues to be provided with notice of any and all future considerations of these applications and/or decisions related thereto.


Yours very truly,


ZELINKA PRIAMO LTD.


Brooke Burlock, B.A., MPlan Planner

- cc. CP REIT Ontario Properties Limited (via email)
- Encl. Site Plan for Approved Shoppers Drug Mart

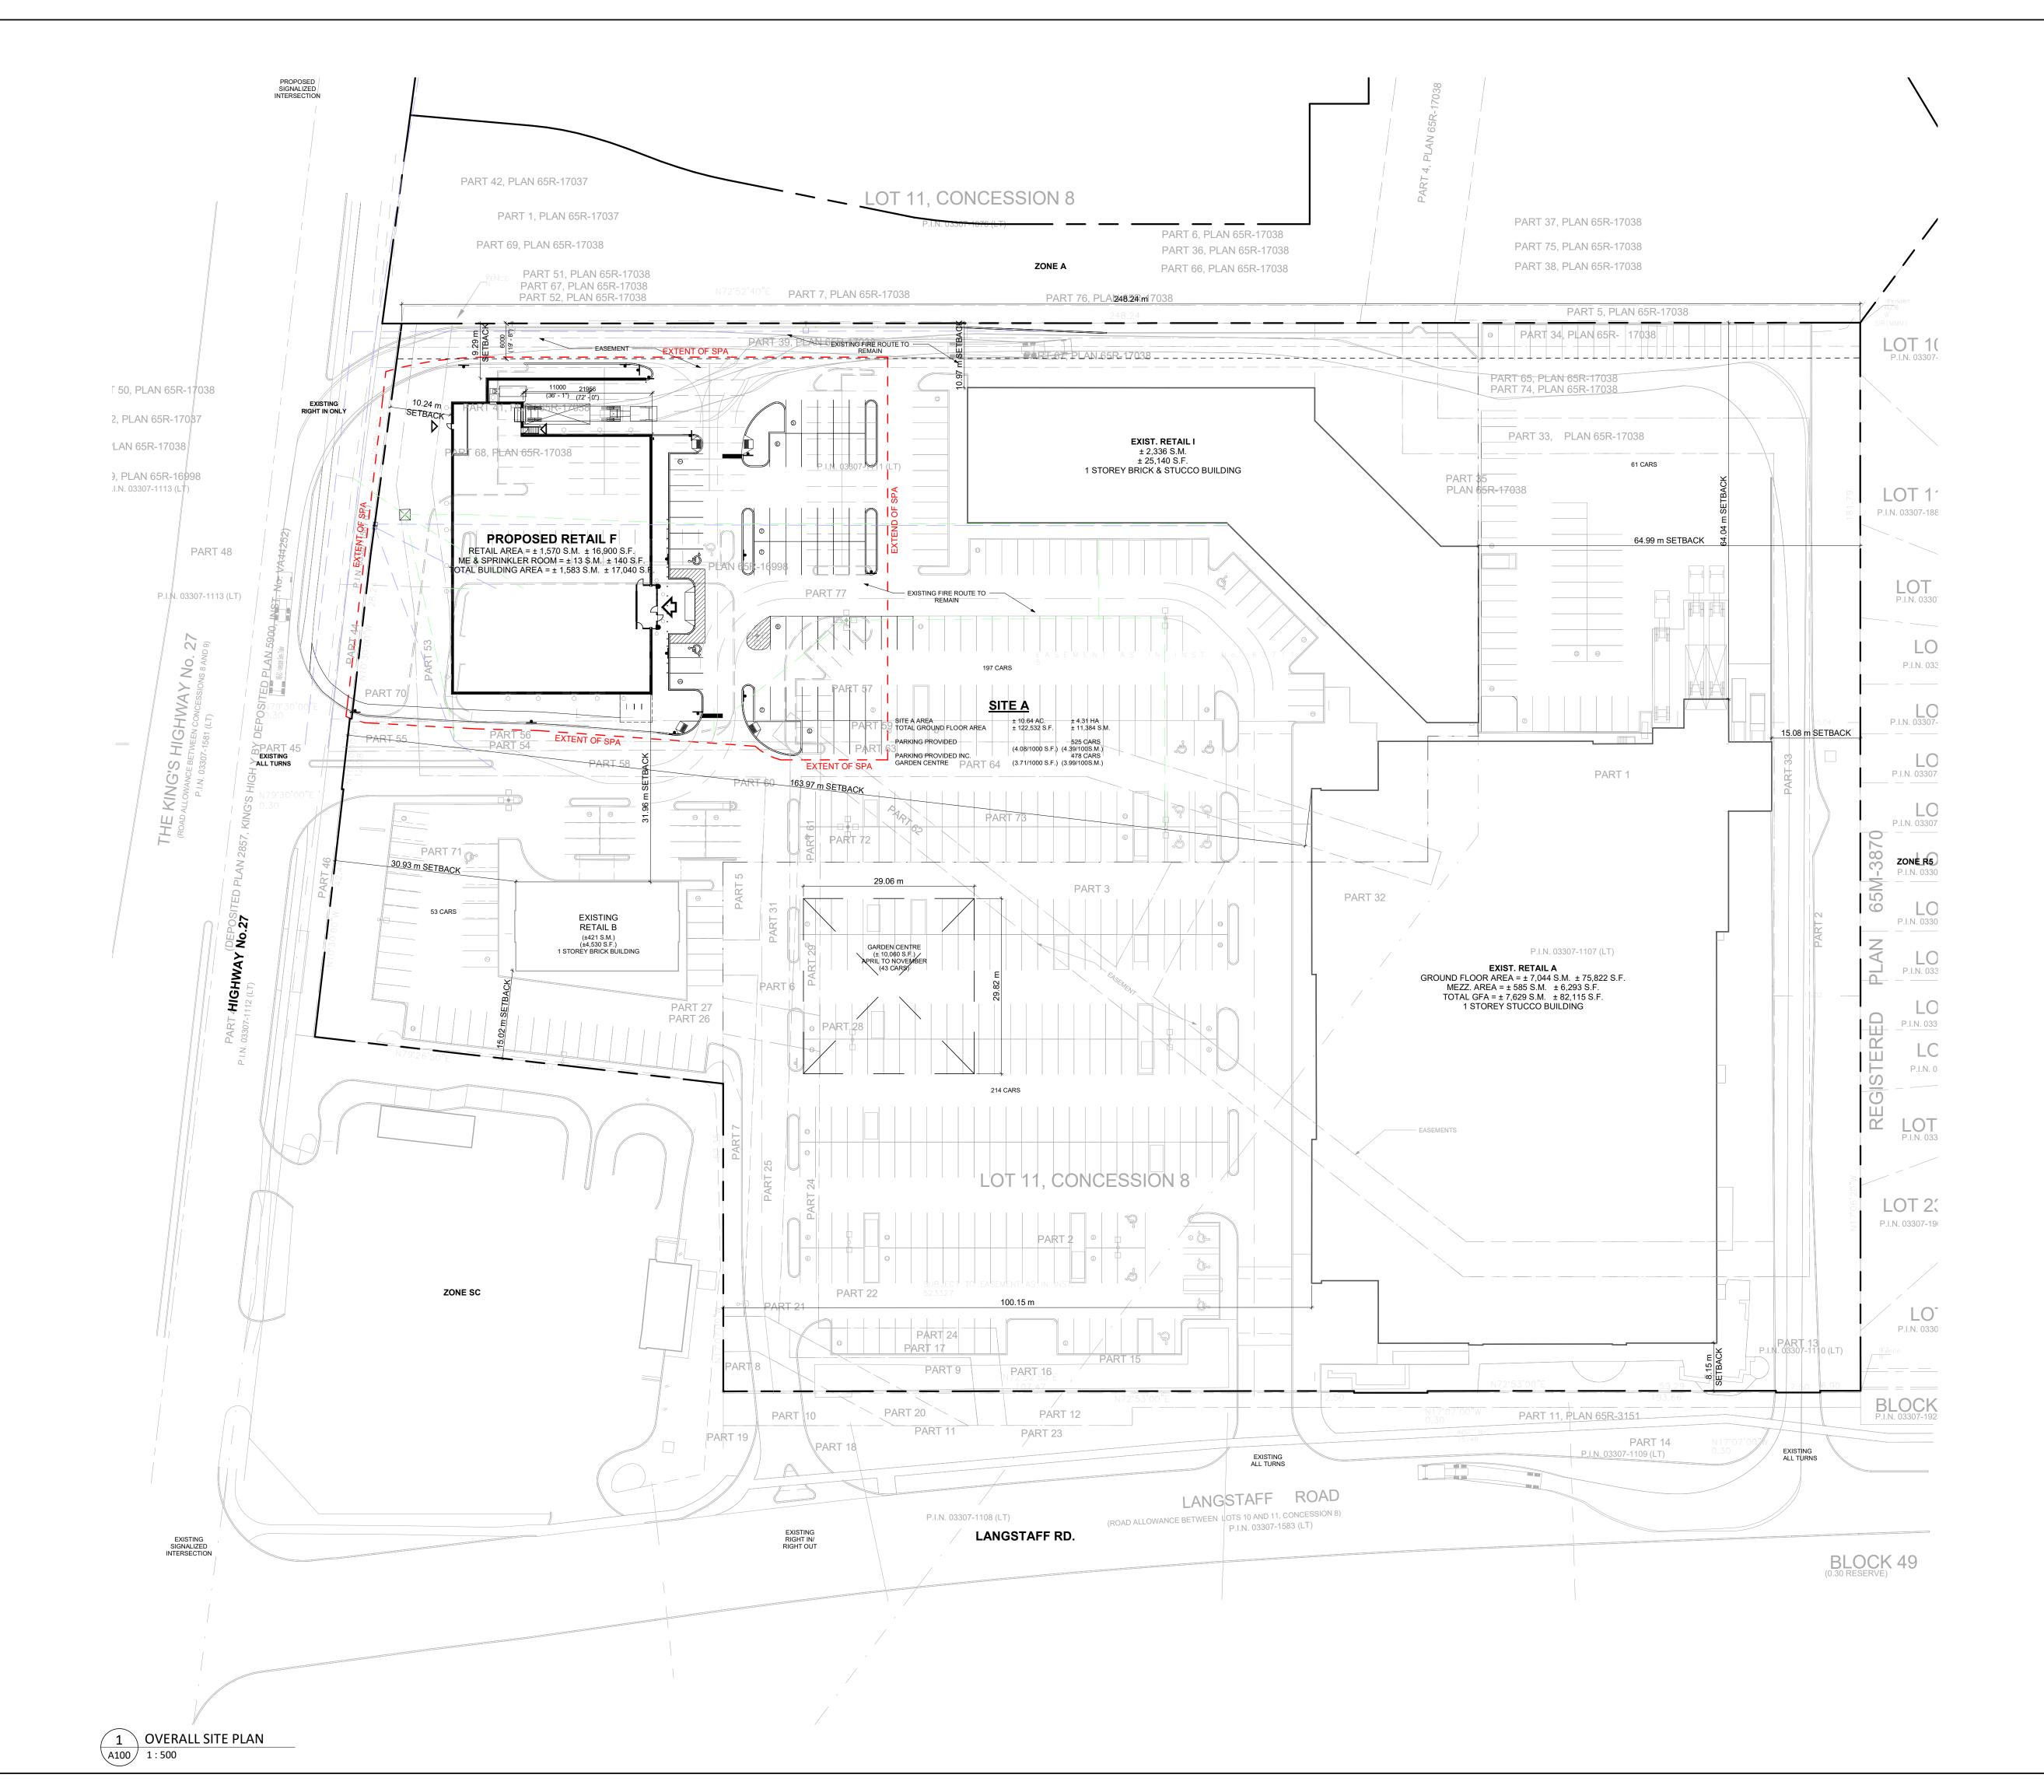

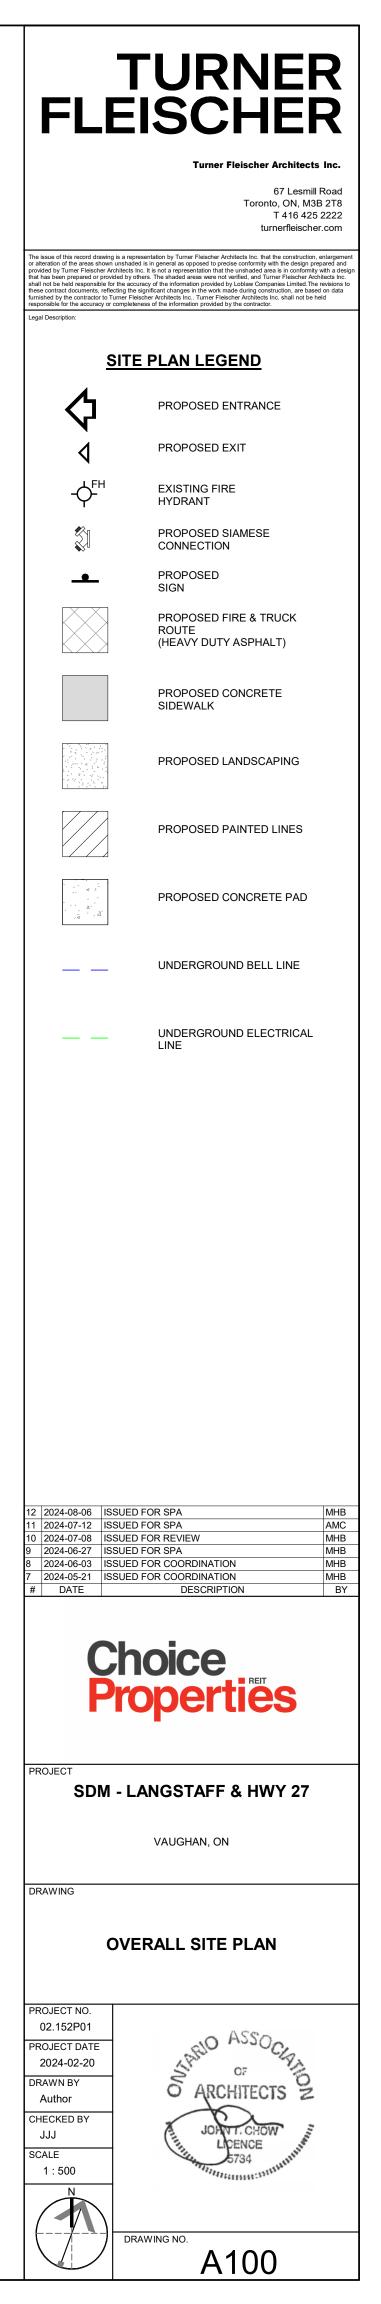

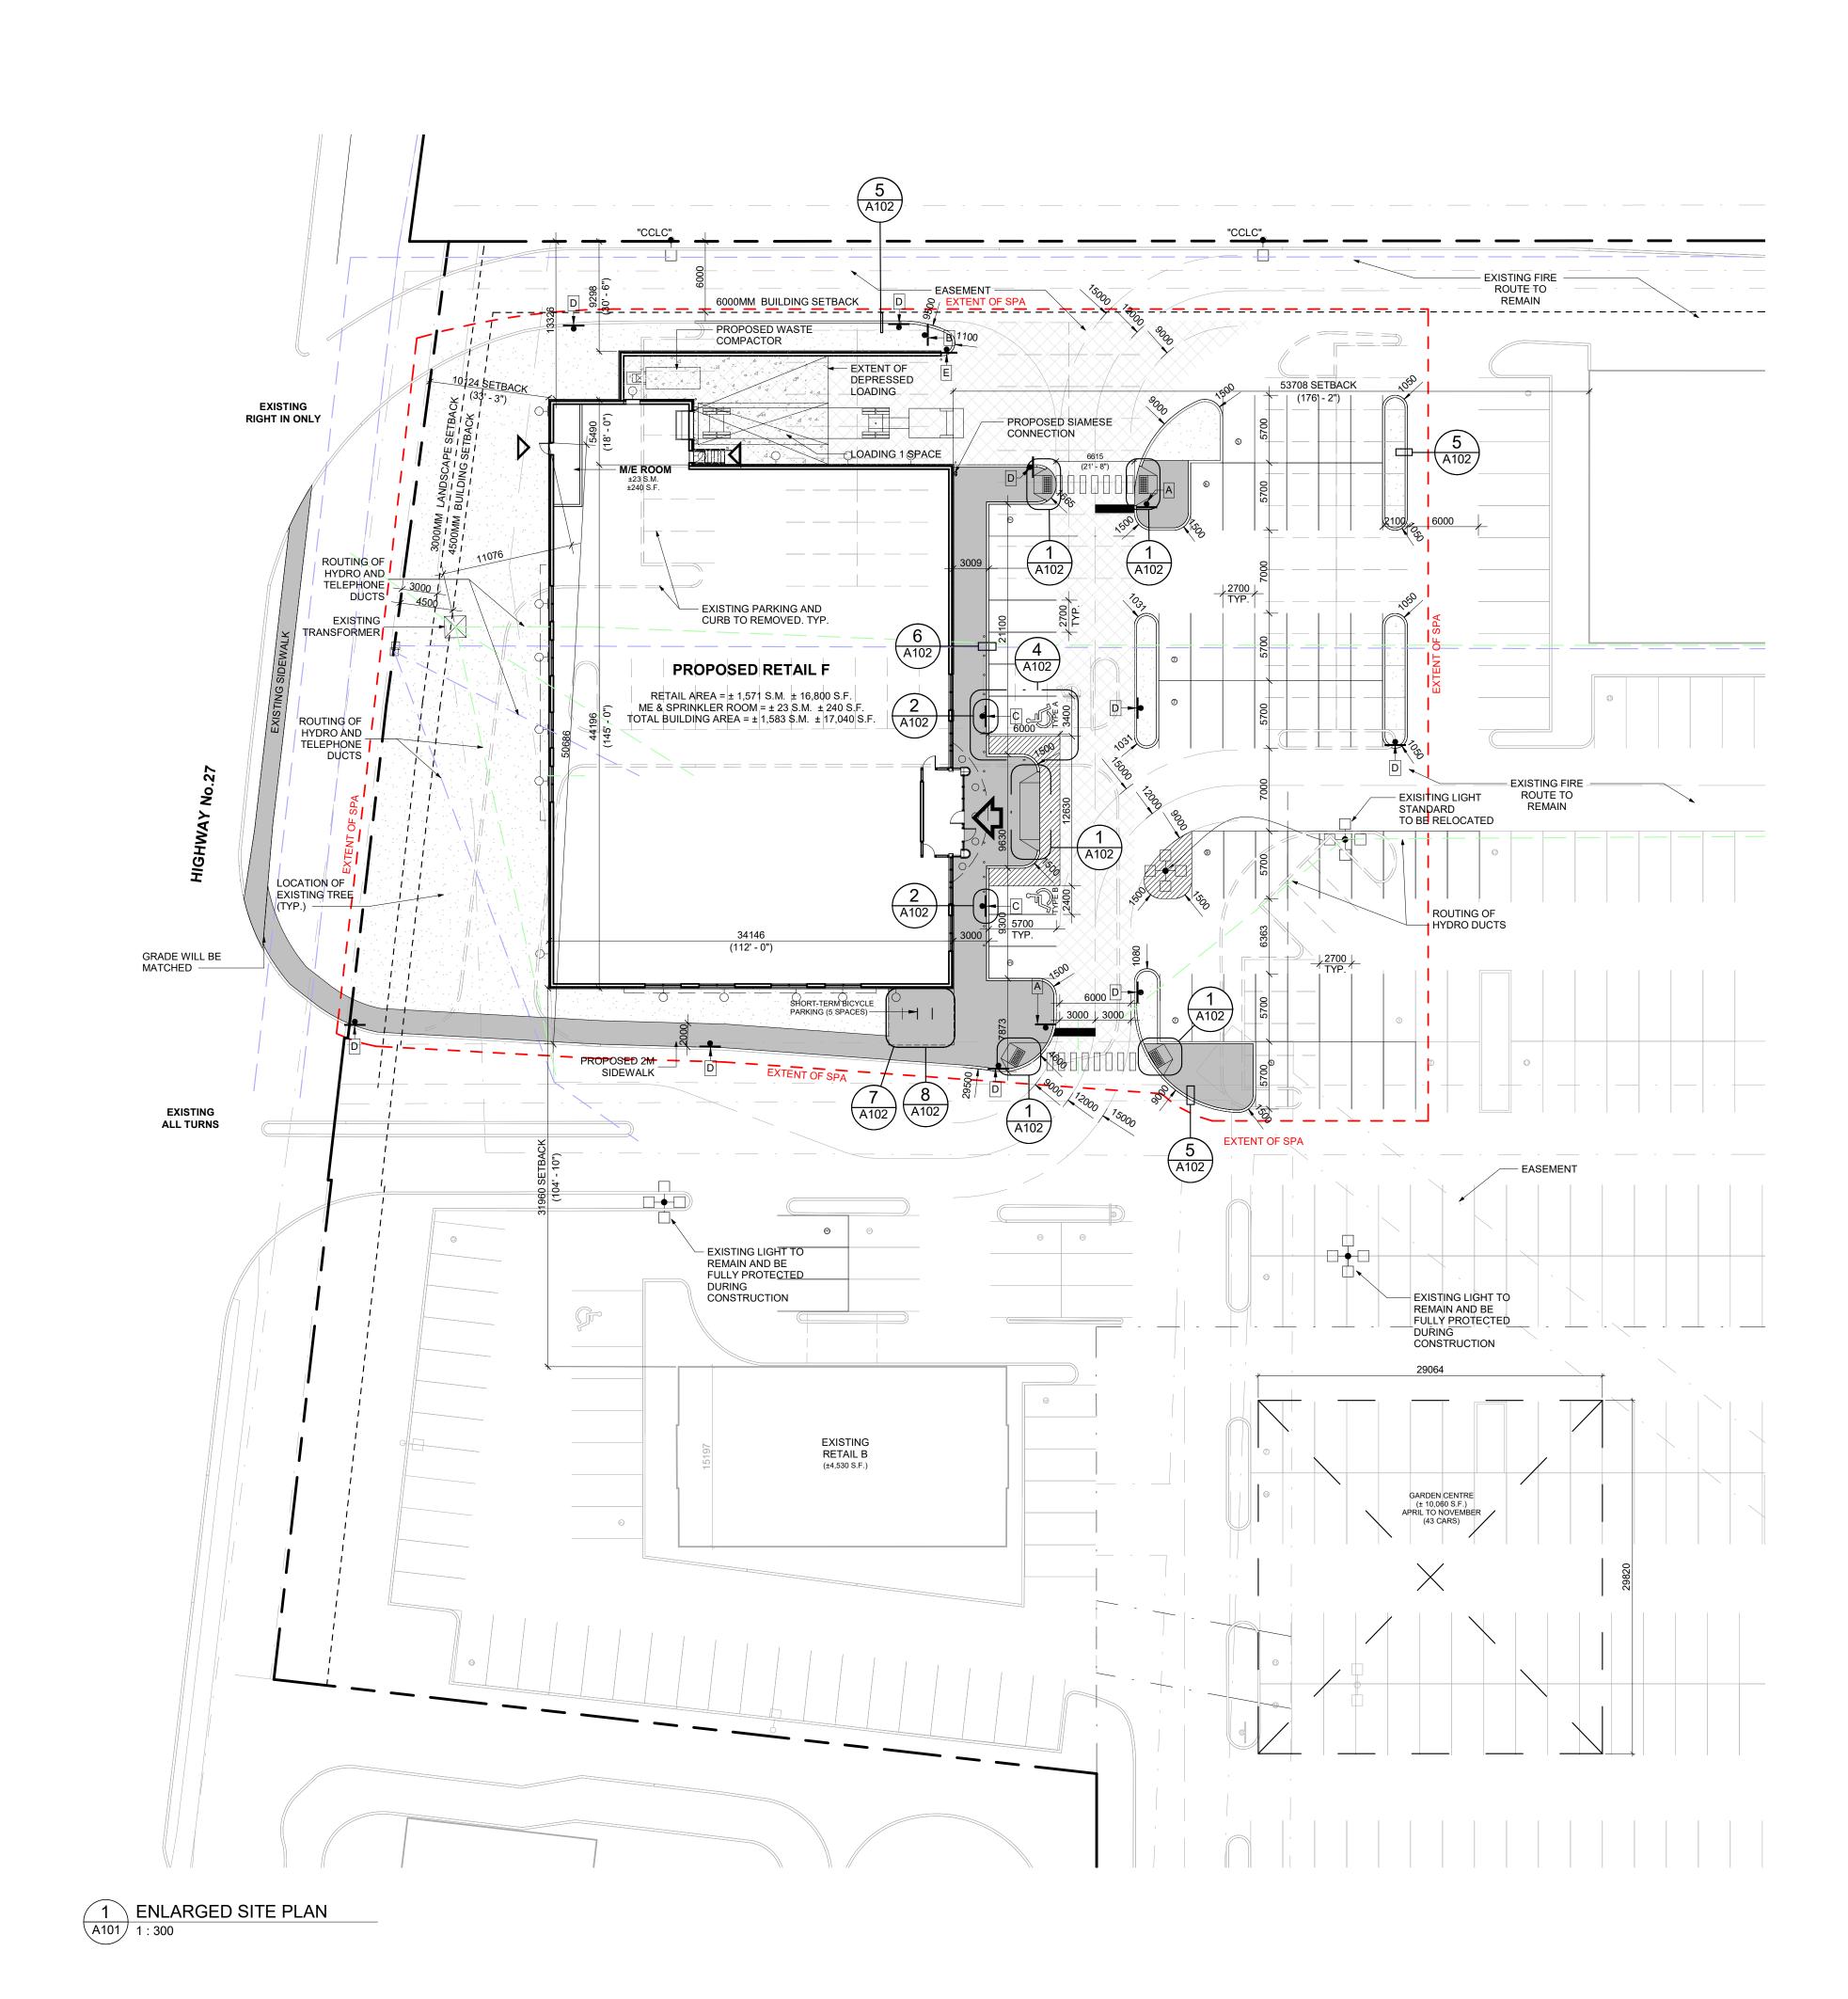

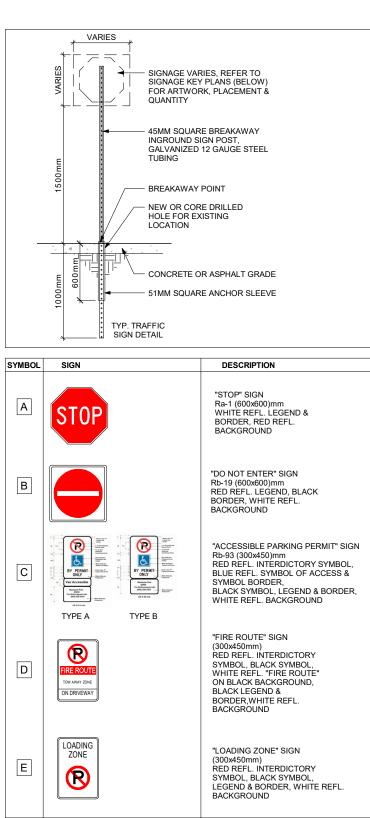



CONTEXT SITE PLAN

STATISTICS			
SITE A AREA	±10.64 ACRES	±4.31 HA.	
FUTURE DEVELOPMENT A AREA	±2.19 ACRES	±0.89 HA.	
FUTURE DEVELOPMENT B AREA	±5.96 ACRES	±2.41 HA.	
TOTAL SITE AREA	±18.79 ACRES	±7.60 HA.	
EXISTING RETAIL A AREA	±82,115 S.F.	±7,629 S.M.	
GROUND FLOOR AREA	±75,822 S.F.	±7,044 S.M.	
MEZZANINE AREA	±6,293 S.F.	±585 S.M.	
EXISTING RETAIL B AREA	±4,530 S.F.	±421 S.M.	
EXISTING RETAIL I AREA	±25,140 S.F.	±2,336 S.M.	
PROPOSED RETAIL F AREA	±17,040 S.F.	±1,583 S.M.	
TOTAL RETAIL AREA	±128,825 S.F.	±11,968 S.M.	
TOTAL GROUND FLOOR AREA	±122,532 S.F.	±11,384 S.M.	
PARKING PROVIDED	525 CARS		
(N.I.C GARDEN CENTRE)	4.08/1000 S.F.	4.39/100 S.M.	
PARKING PROVIDED	478 CARS		
(INC GARDEN CENTRE)	3.71/1000 S.F.	3.99/100 S.M.	
COVERAGE (SITE A)	26.44%		

ZONING CHART		
ZONE: NC (NEIGHBOURHOOD COMMERCIAL)		
PROVISION	REQUIRED	PROVIDED
MAXIMUM LOT AREA	±25,000 S.M.	±43,051 S.M.
MINIMUM SETBACKS - BUILDING F		
FRONT	11.0M	10.24M
INTERIOR SIDE (ABUT. "A" ZONE)	6.0M	9.29M
INTERIOR SIDE (TO BUILDING B)	7.5M	31.96M
REAR (TO BUILDING I)	7.5M	53.70M
EXTERIOR SIDE (ABUT. LANGSTAFF RD.)	6.0M	N/A
MAXIMUM LOT COVERAGE	33%	26.44%
MAXIMUM BUILDING HEIGHT	11M	7M
MAXIMUM GROSS FLOOR AREA*	±11,873 S.M.*	±11,384 S.M.
MINIMUM LANDSCAPE AREA	10%	12% ±5,347 S.M.
ANDSCAPING SETBACK		
ABUTTING OPEN SPACE/RES.	2.4M	N/A
ABUTTING STREET	3.0M	9.0M
PARKING REQUIRED*	481 CARS*	525 CARS
(N.I.C GARDEN CENTRE)		
PARKING REQUIRED*	481 CARS*	478 CARS
INC GARDEN CENTRE)		
BARRIER FREE PARKING - BUILDING F		
ГҮРЕ А (3.4 М х 5.7 М)	1 SPACE	1 SPACE
ГҮРЕ В (2.4 М х 5.7 М)	1 SPACE	1 SPACE
BARRIER FREE ACCESS AISLE W	1.5 N	1
TOTAL OVERALL BARRIER FREE PARKING	10 + 2 SPACES	16 SPACES
2+2% OF TOTAL PROVIDED PARKING SPACES FOR 200-1,000 SPACES)		
MININUM AISLE	6.0M	6.0M
MININUM LOADING SPACE	9.0 M X 3.5 M	9.0 M X 3.5 M
501-2500 SQ.M	1 SPACE	3 SPACES
2501-10,000 SQ.M	2 SPACES	
ABOVE 10,000 SQ.M	2+1/10,000S.M.	
BICYCLE PARKING - SHORT TERM	3 SPACES	5 SPACES

REQUIRED PER MINOR VARIANCE: "LOADING FACILITIES FOR THE SUBJECT LANDS SHALL BE PERMITTED IN THE AREAS SHOWN AS "LOADING AREA" ON SCHEDULE E-833 TO EXCEPTION 9(750)". PROVIDED:"TO PERMIT THE LOCATION OF THE LOADING SPACE OF RETAIL F AS SHOWN ON THE ATTACHED SKETCH".

* INDICATES APPROVED MINOR VARIANCES PER APPLICATION A353/17

areas shown unshar Fleischer Architects ared or provided by esponsible for the ac uments, reflecting th ontractor to Turner F	presentation by Turner Fleischer Architects inc. that the construction, enlargement ded is in general as opposed to precise conformity with the design prepared and inc. It is not a representation that the unshaded area is in conformly with a design others. The shaded areas were not verified, and Turner Fleischer Architects inc. curacy of the information provided by Loblave Companies Limited. The revisions to e significant changes in the work made during construction, are based on data leischer Architects Inc Turner Fleischer Architects Inc. shall not be held teness of the information provided by the contractor.			
SITE PLAN LEGEND				
5	PROPOSED ENTRANCE			
4	PROPOSED EXIT			
¢ ^{FH}	EXISTING FIRE HYDRANT			
Š I	PROPOSED SIAMESE CONNECTION			
•	PROPOSED SIGN			
	PROPOSED FIRE & TRUCK ROUTE (HEAVY DUTY ASPHALT)			
	PROPOSED CONCRETE SIDEWALK			
	PROPOSED LANDSCAPING			
	PROPOSED PAINTED LINES			
2. 2.	PROPOSED CONCRETE PAD			

TURNER FLEISCHER


The issue of this red or alteration of the a provided by Turner that has been prepa shall not be held re-these contract docu furnished by the col responsible for the a

Turner Fleischer Architects Inc.

67 Lesmill Road Toronto, ON, M3B 2T8 T 416 425 2222 turnerfleischer.com

UNDERGROUND BELL LINE

UNDERGROUND ELECTRICAL

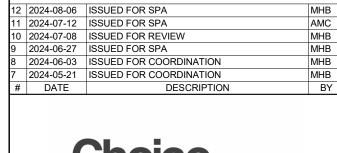

 2
 2024-08-06
 ISSUED FOR SPA

 1
 2024-07-12
 ISSUED FOR SPA



SDM - LANGSTAFF & HWY 27

VAUGHAN, ON

DRAWING


ENLARGED SITE PLAN

DRAWING NO.

PROJECT NO. 02.152P01 PROJECT DATE 2024-02-20 DRAWN BY MHB CHECKED BY JJJ SCALE As indicated




A101

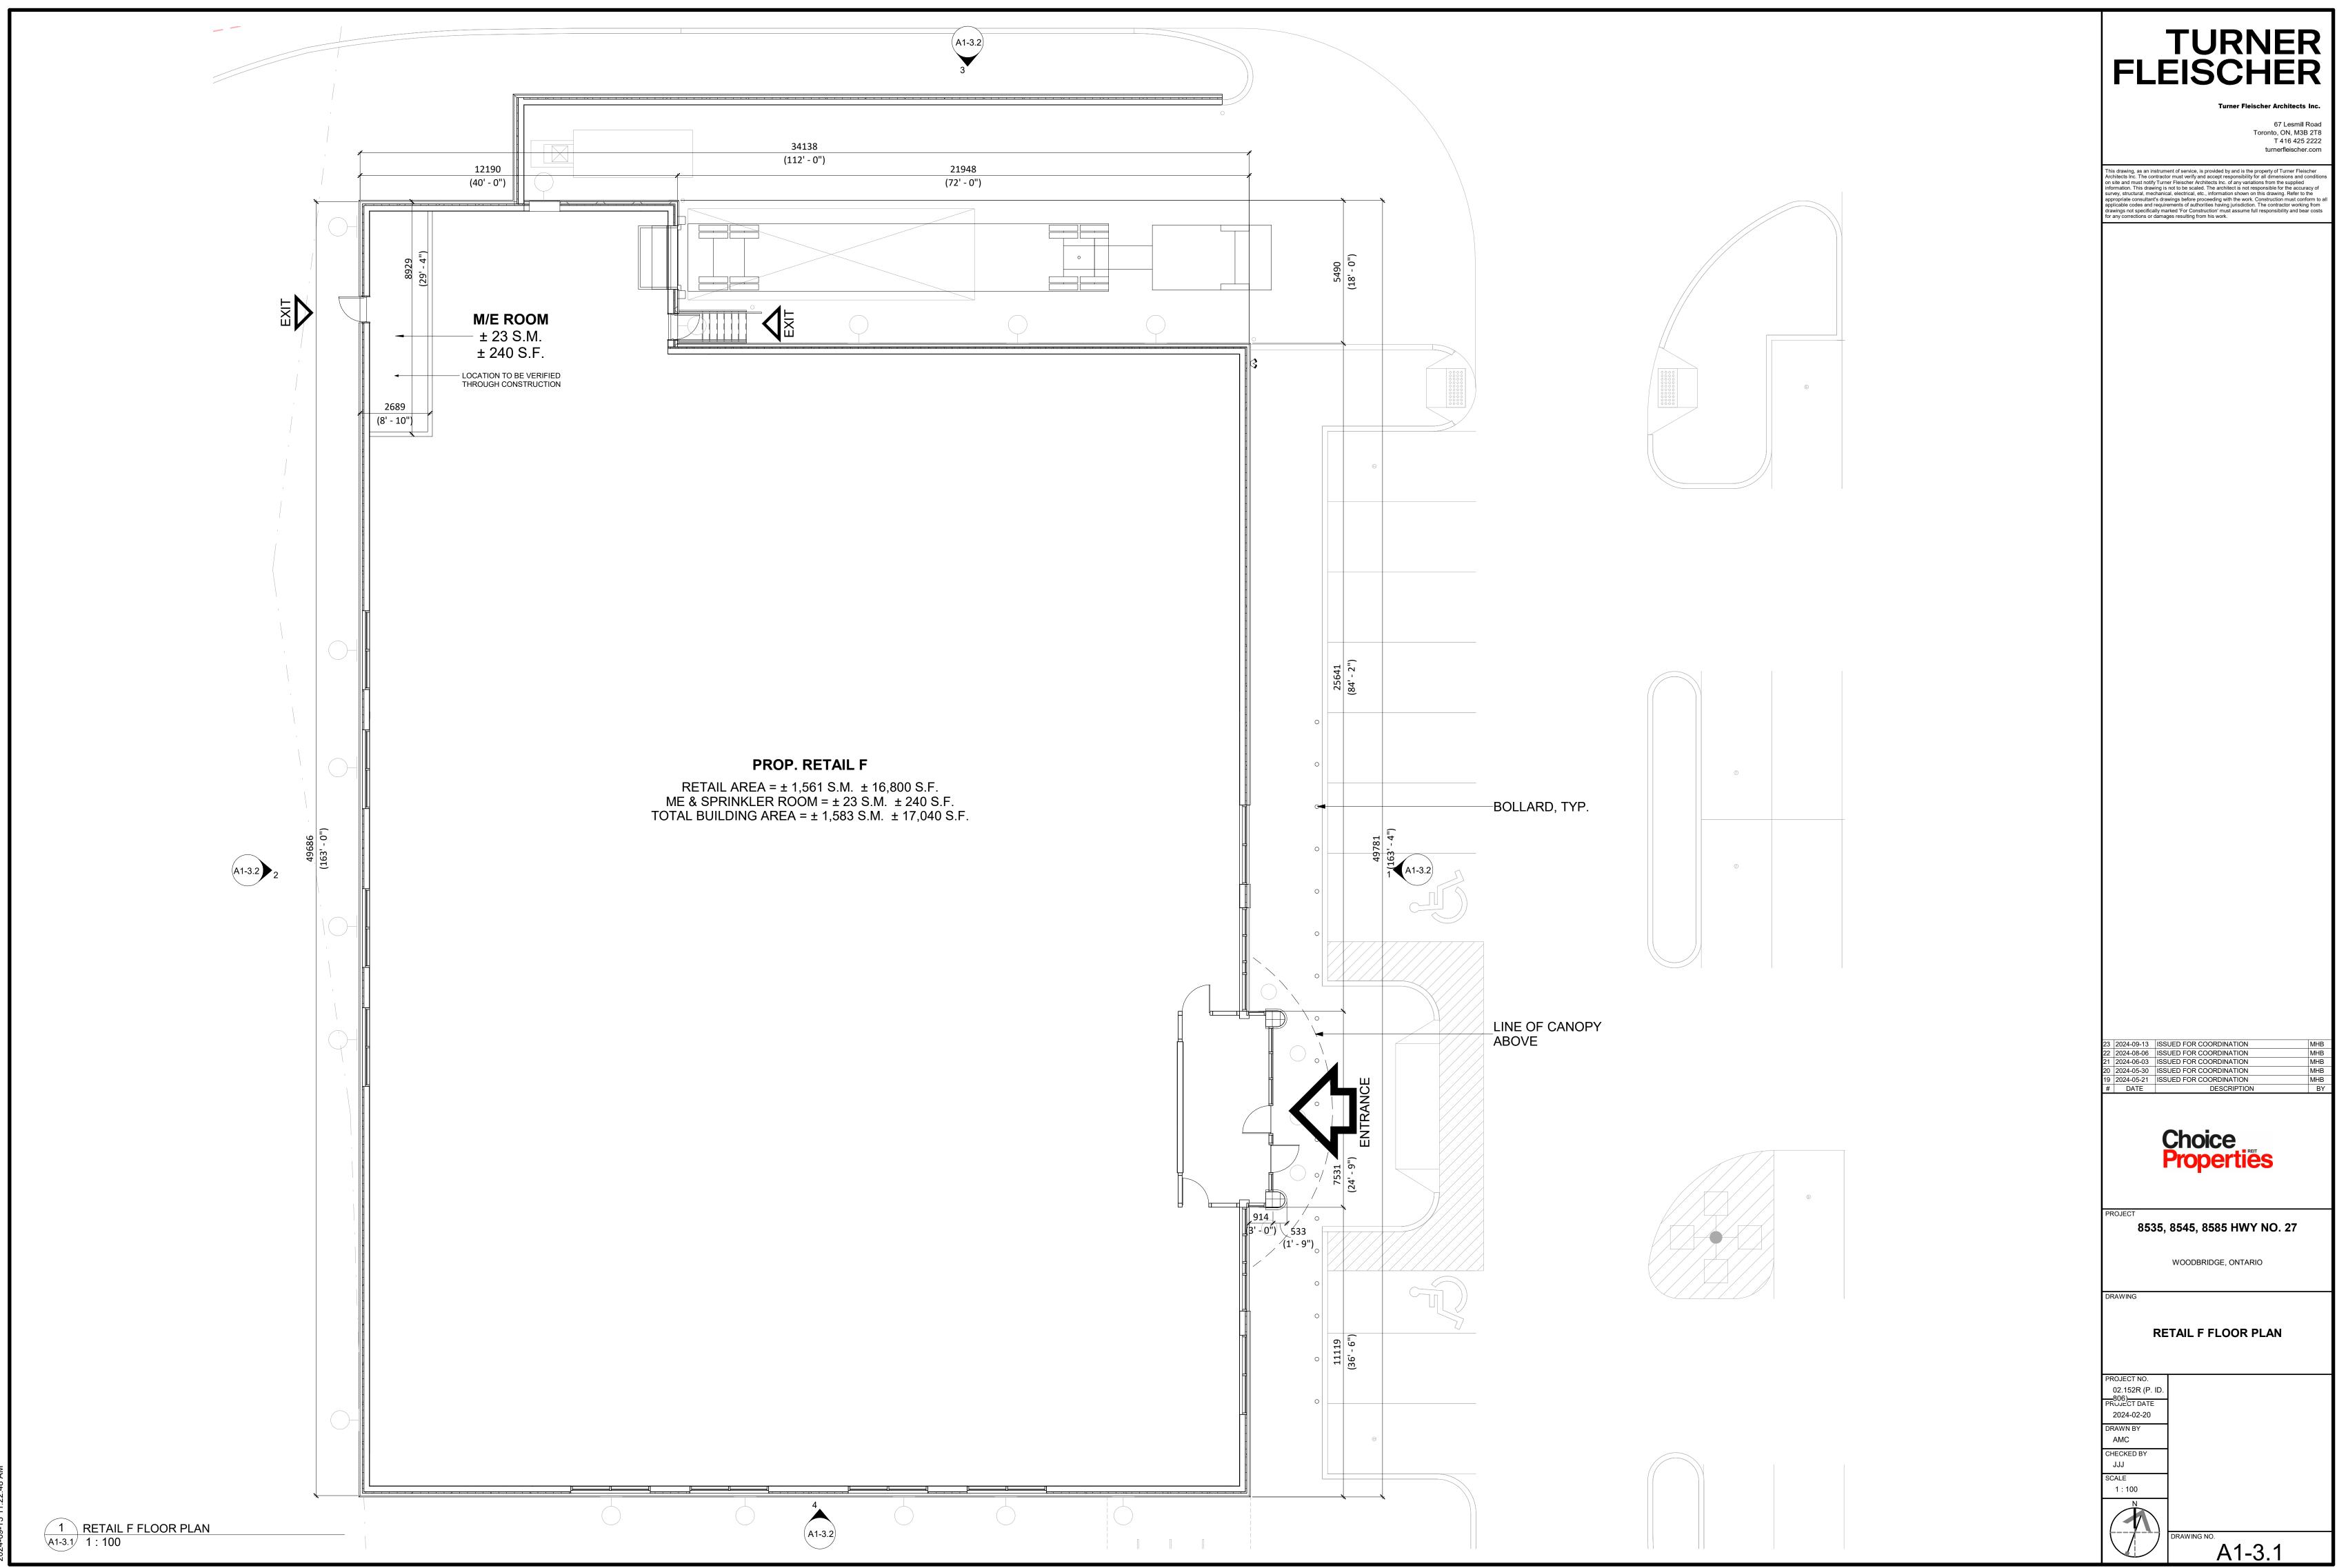


24-09-13 11:22:48 AN




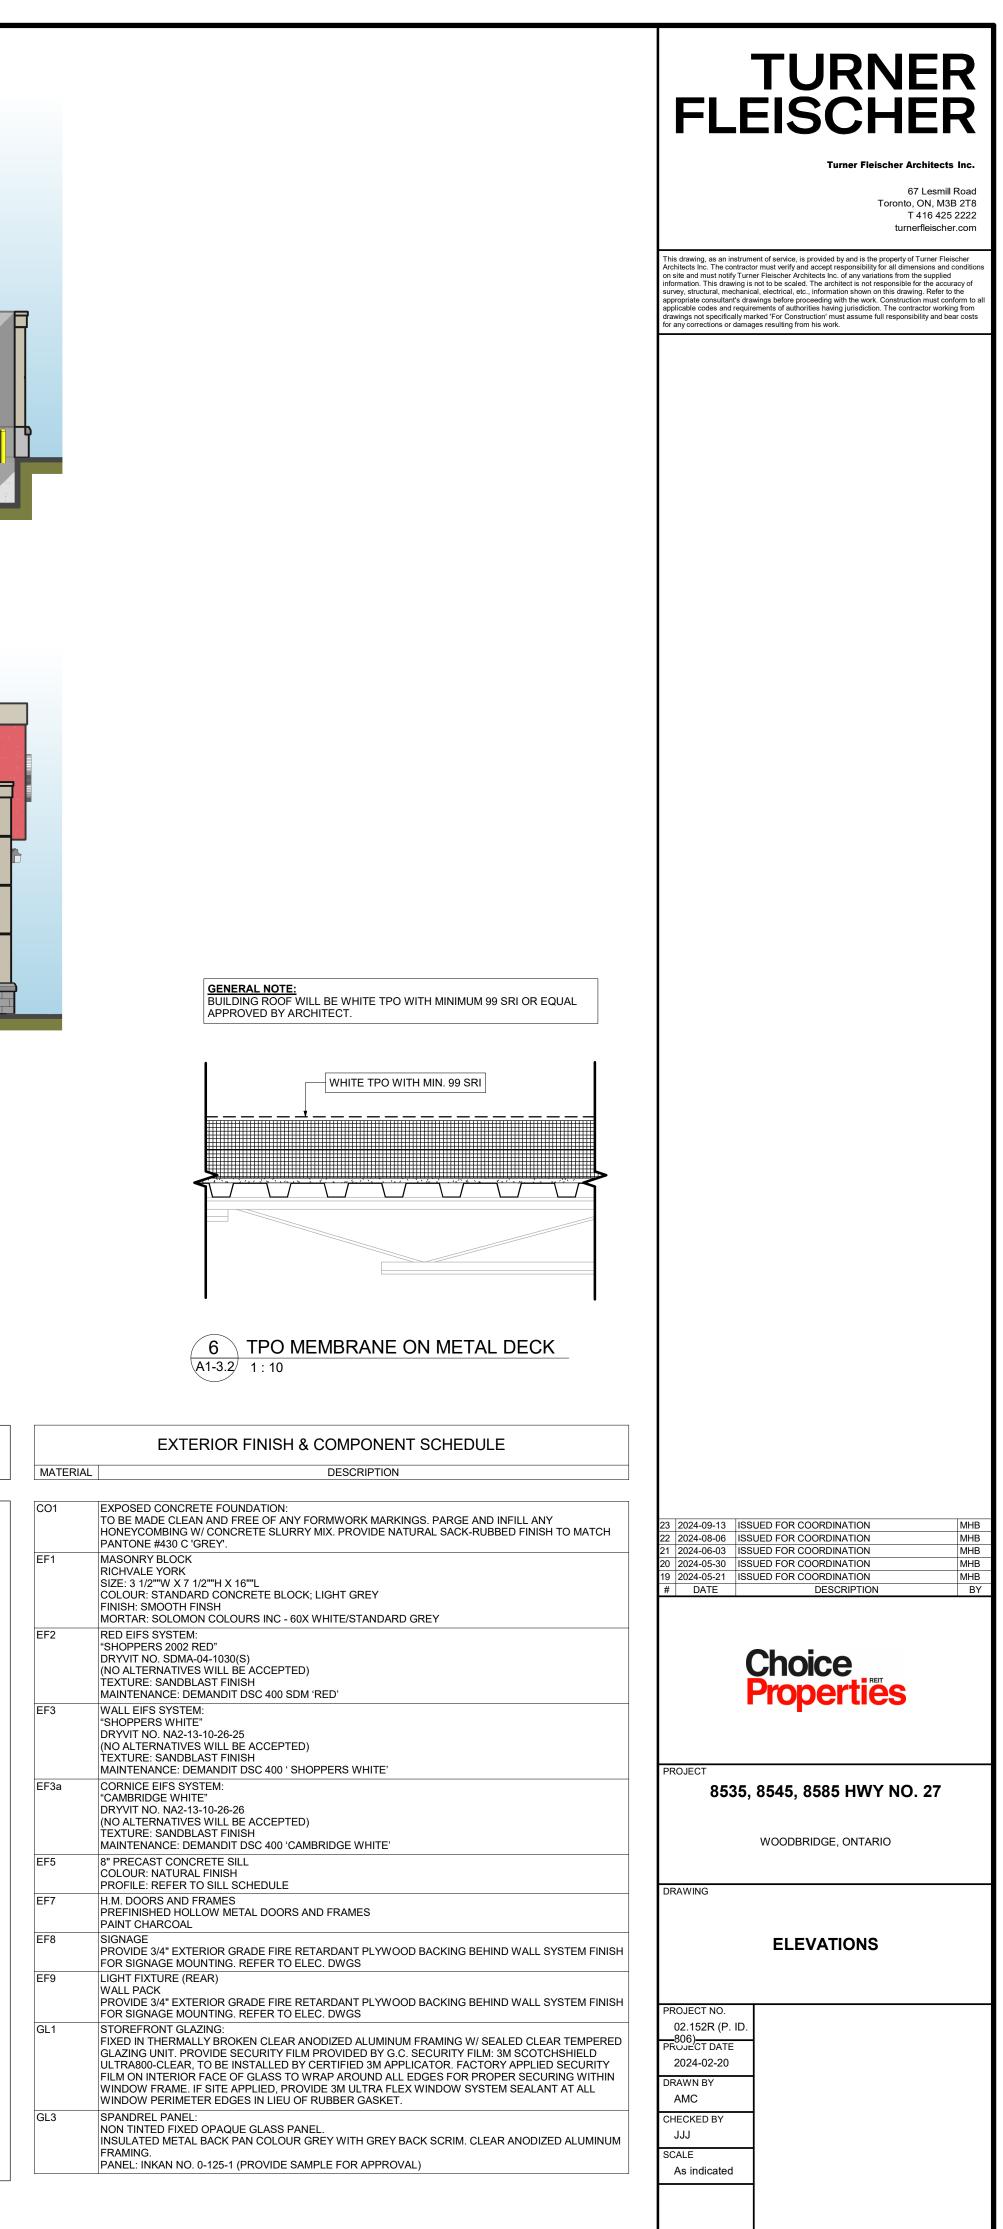



RAWING NO.

A1-3.2

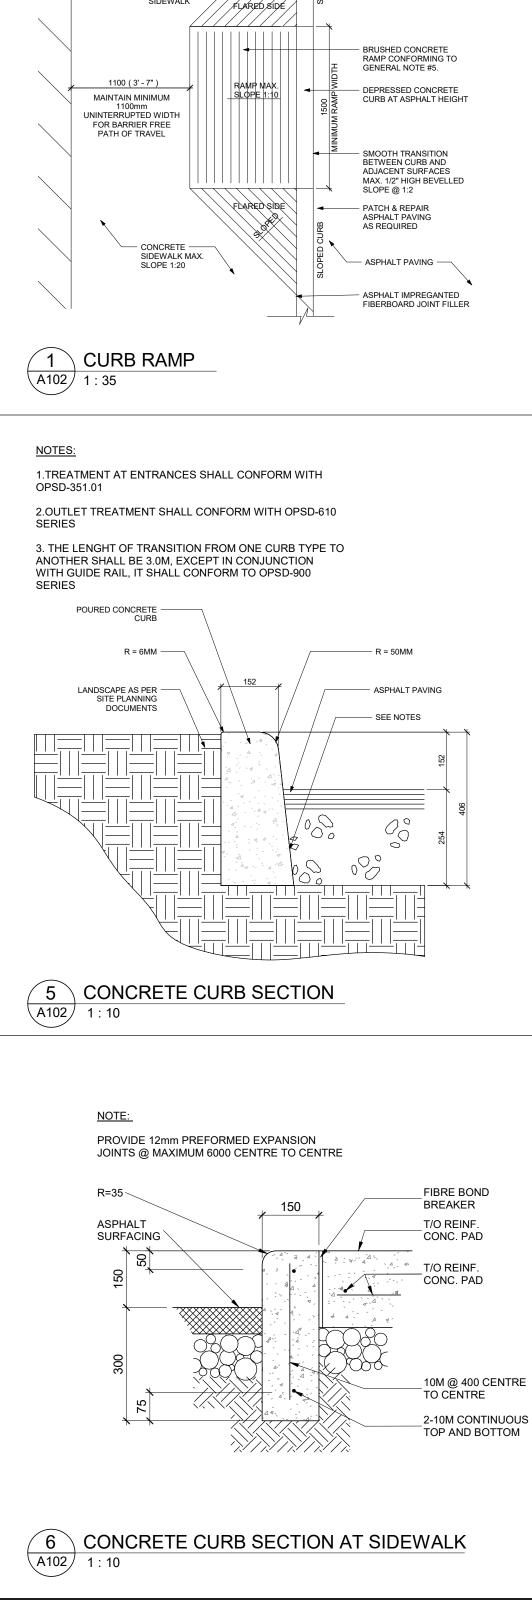

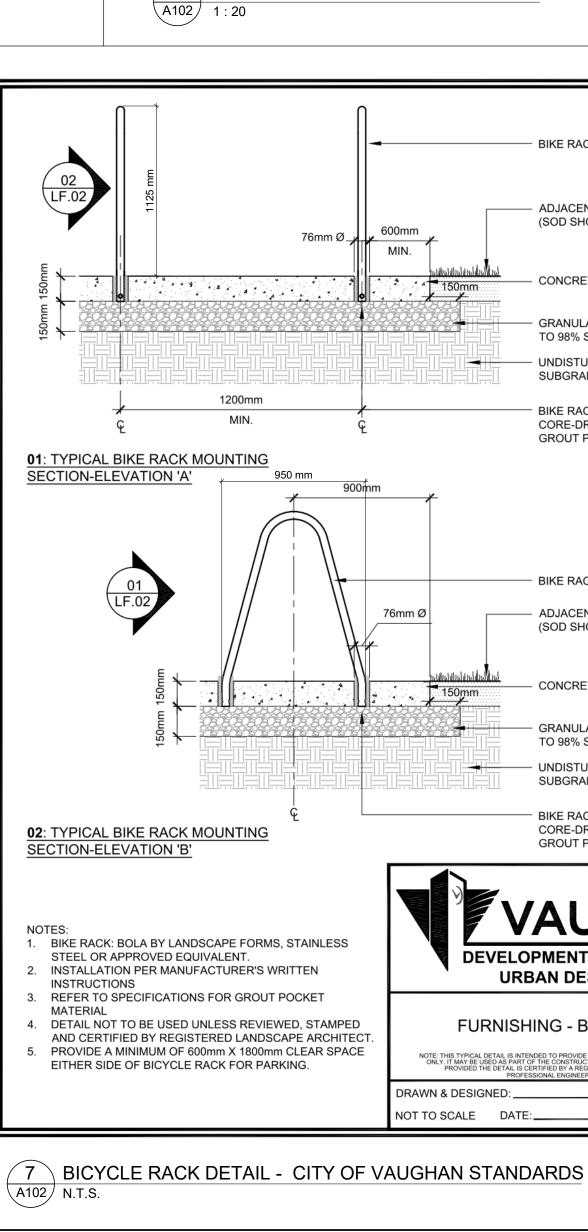

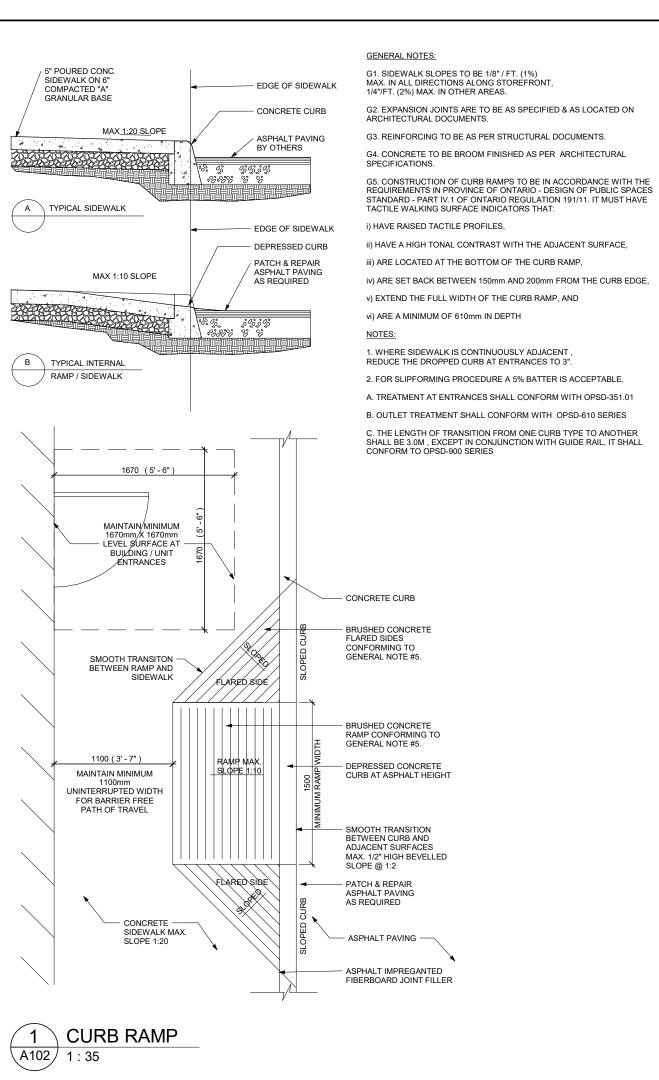


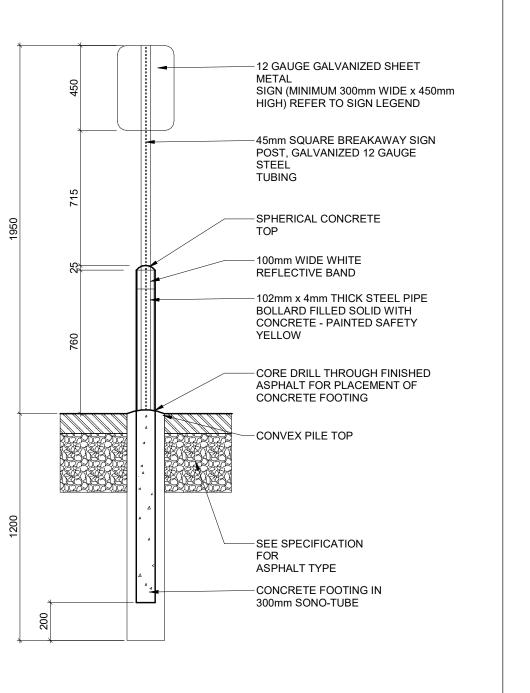

ACCESSIBLE SIGN WITH BOLLARD

_2`

GRANULAR 'A' COMPACTED TO 98% S.P.D. - UNDISTURBED OR COMPACTED SUBGRADE TO 98% S.P.D. BIKE RACK LEG CENTERED IN CORE-DRILLED 76 Ø NON-SHRINK GROUT POCKET TYP. BIKE RACK ADJACENT SURFACE (SOD SHOWN.) CONCRETE PAVING GRANULAR 'A' COMPACTED TO 98% S.P.D. - UNDISTURBED OR COMPACTED SUBGRADE TO 98% S.P.D. BIKE RACK LEG CENTERED IN CORE-DRILLED 76 Ø NON-SHRINK GROUT POCKET TYP. VAUGHAN **DEVELOPMENT PLANNING DEPT.** URBAN DESIGN DIVISION FURNISHING - BICYCLE RACK NOTE: THIS TYPICAL DETAIL IS INTENDED TO PROVIDE DESIGN DIRECTION AND IS FOR REFERENC ONLY. IT MAY BE USED AS PART OF THE CONSTRUCTION PACKAGE OR SITE PLAN APPLICATION PROVIDED THE DETAIL IS CERTIFIED BY A REGISTERED LANDSCAPE ARCHITECT OR STD. DWG. NO. ULA 019

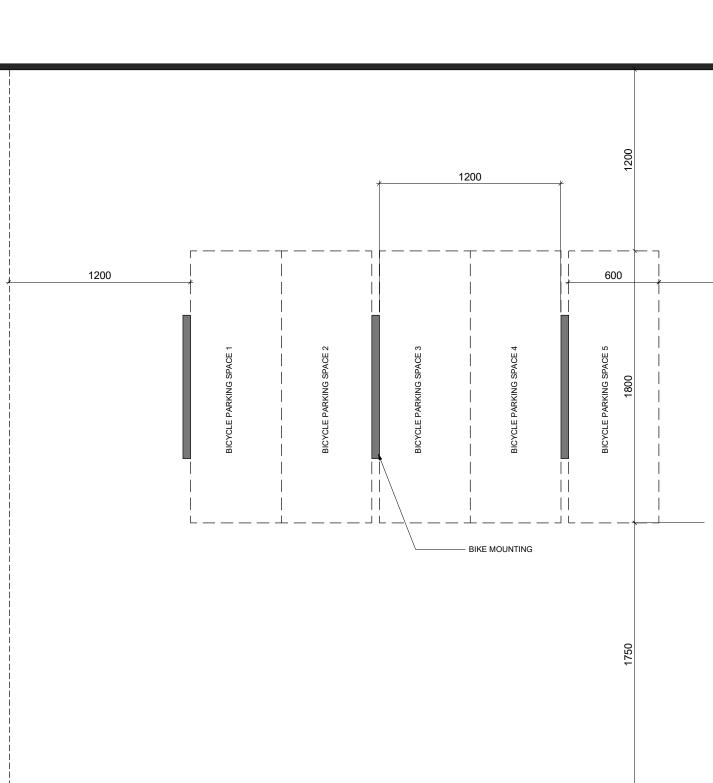




- BIKE RACK

ADJACENT SURFACE


CONCRETE PAVING

(SOD SHOWN.)

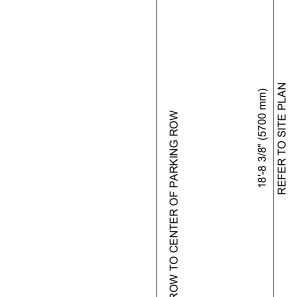

____**_**___

A102 1 : 50

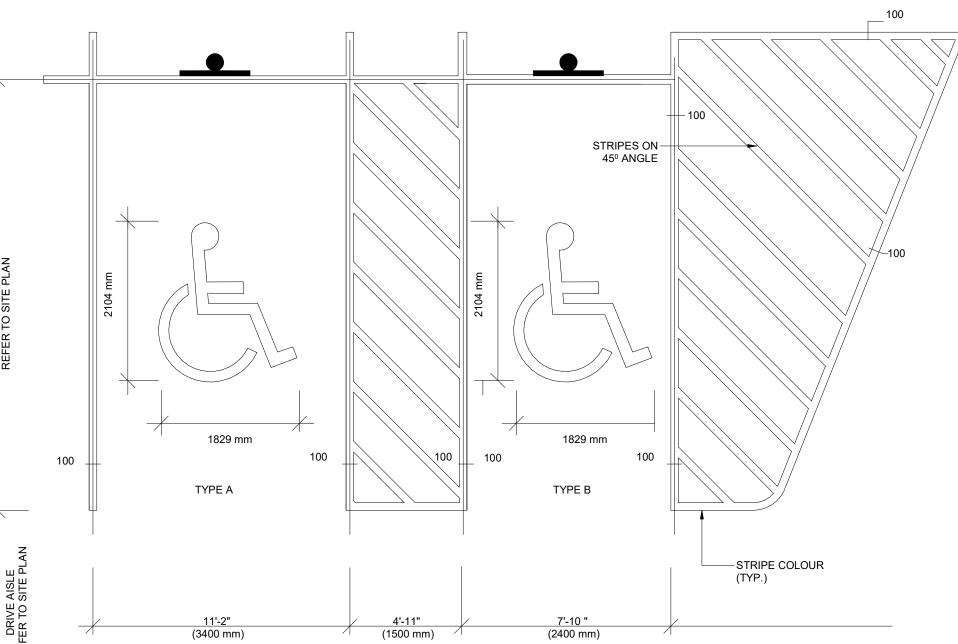


NOTES:

1. REFER TO SITE PLAN FOR SPECIFIC PROJECT SITE PLANNING DIMENSIONS.

2. ALL PARKING LOT LINE STRIPING TO BE PAINTED WITH PARA PAINT '8 MPI - YELLOW' OR EQUAL. 3. ALL PARKING DIMENSIONS SHOWN ARE MINIMUM. CONFIRM REQUIRED SIZES WITH LOCAL AUTHORITY HAVING JURISDICTION. 4. REFER TO SITE PLAN FOR END CONDTION (8" LINE OR HATCHED PAINTED ISLAND)

4 STANDARD PARKING DETAIL (AODA)

A102 1 : 25

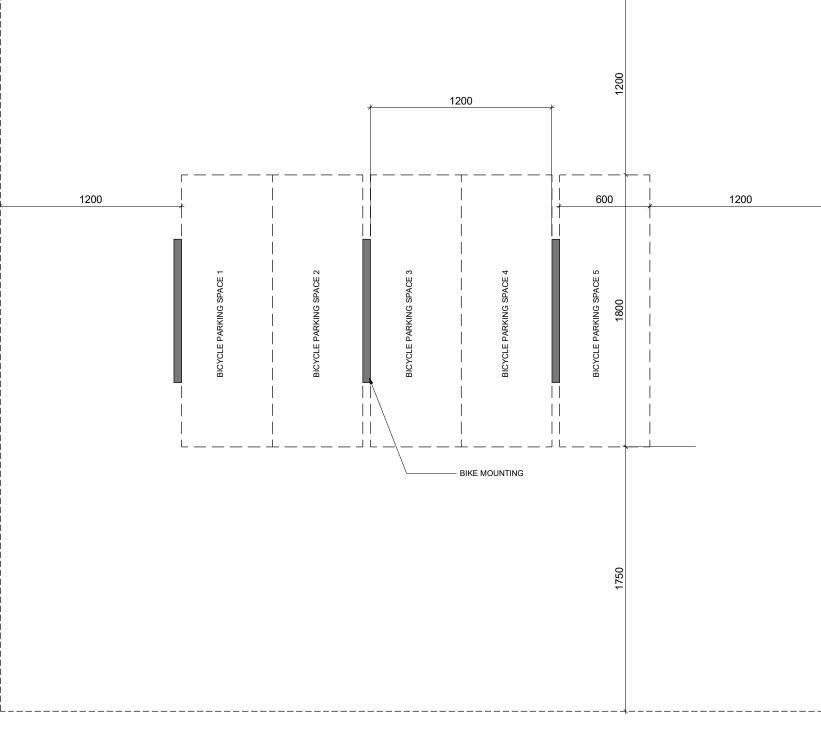

8 BICYCLE RACK DETAIL - 5 SPACES



e of this record drawing is a representation by Turner Fleischer Architects Inc. that the construction, enlarge tion of the areas shown unshaded is in general as opposed to precise conformity with the design prepared a by Turner Fleischer Architects Inc. It is not a representation that the unshaded area is in conformity with a been prepared or provided by others. The shaded areas were not verified, and Turner Fleischer Architects I

as been proported by provide by the accuracy of the information provided by Loblaw Companies Limited. The revision contract documents, reflecting the significant changes in the work made during construction, are based on dat hed by the contractor to Turner Fleischer Architects linc. Turner Fleischer Architects linc. shall not be held mither the terminate and the information provided by the contractor.

12 2024-08-06 ISSUED FOR SPA MHB AMC MHB MHB MHB MHB MHB MHB MHB MHB MHB 1 2024-07-12 ISSUED FOR SPA 0 2024-07-08 ISSUED FOR REVIEW 2024-06-27 ISSUED FOR SPA 2024-06-03 ISSUED FOR COORDINATION 2024-05-21 ISSUED FOR COORDINATION 2024-05-10 ISSUED FOR COORDINATION 2024-05-06 ISSUED FOR COORDINATION 2024-04-29 ISSUED FOR COORDINATION 2024-04-24 ISSUED FOR COORDINATION # DATE DESCRIPTION



SDM - LANGSTAFF & HWY 27

VAUGHAN, ON

DRAWING

SITE DETAILS

PROJECT NO. 02.152P01 PROJECT DATE 2024-02-20 DRAWN BY Author CHECKED BY JJJ SCALE As indicated



DRAWING NO. A102