


PROPOSED PARKING LOT
EXPANSION (MINISTRY
OF MUNICIPAL AFFAIRS &
HOUSING (MMAH)
AMENDMENT TO
THE PARKWAY
BELT APPROVED)

RED-LINED TO INCLUDE
1.83m CHAIN LINK FENCE


RED-LINED TO INCLUDE
1.83m CHAIN LINK FENCE

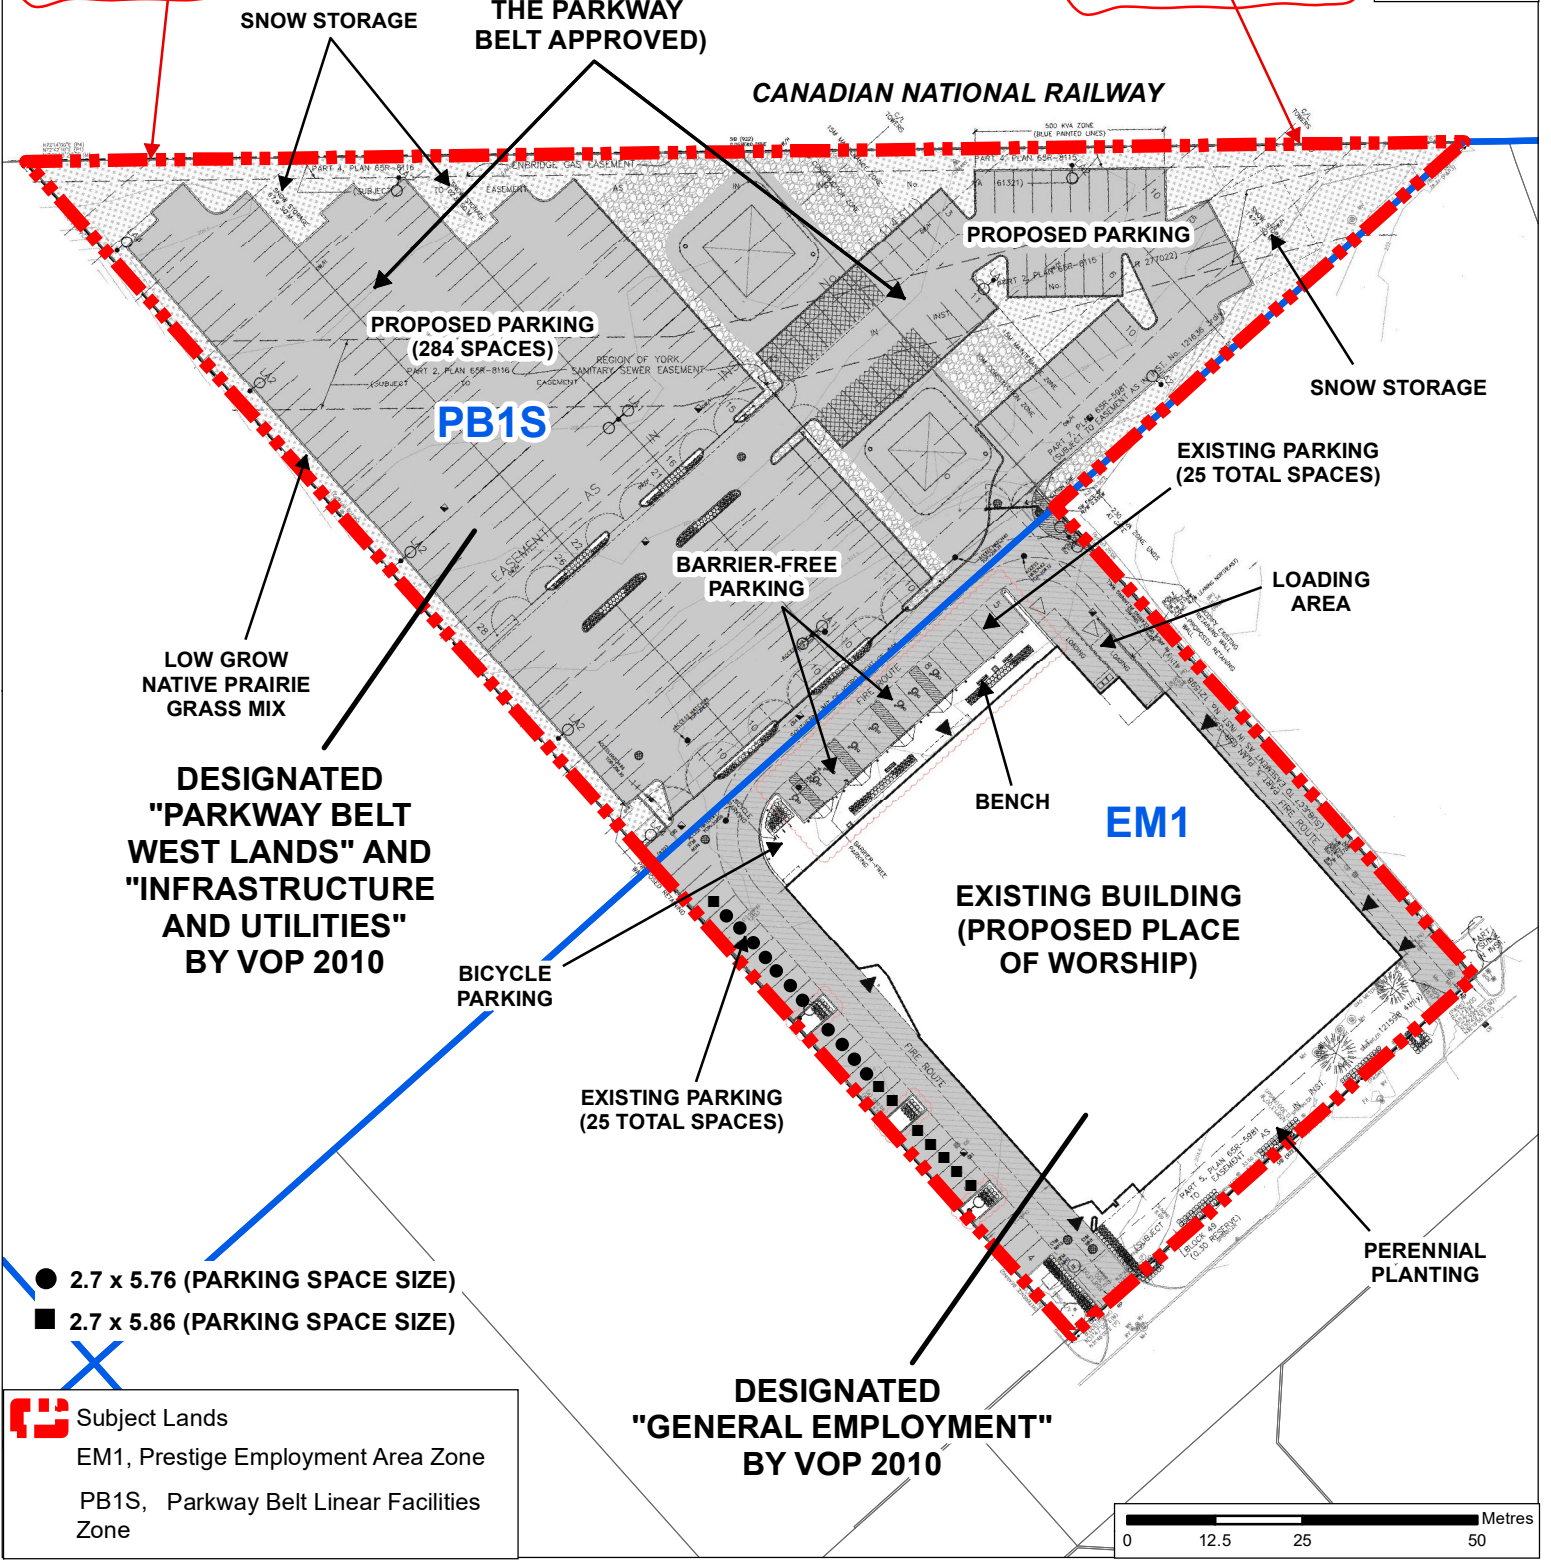


DESIGNATED
"PARKWAY BELT
WEST LANDS" AND
"INFRASTRUCTURE
AND UTILITIES"
BY VOP 2010

DESIGNATED
"GENERAL EMPLOYMENT"
BY VOP 2010

- 2.7 x 5.76 (PARKING SPACE SIZE)
- 2.7 x 5.86 (PARKING SPACE SIZE)

 Subject Lands
EM1, Prestige Employment Area Zone
PB1S, Parkway Belt Linear Facilities Zone

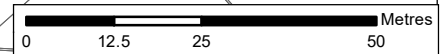

Red-Lined Site Plan

LOCATION: Part of Lot 1, Concession 3;
275 Drumlin Circle

APPLICANT: Covenant Chapel
(The Redeemed Christian Church of God Canada)



Attachment

FILES: Z.18.008 and
DA.18.014

DATE:
June 8, 2021

3