DEVELOPMENT PLANNING DEPARTMENT URBAN DESIGN AND CULTURAL HERITAGE DIVISION

2141 Major Mackenzie Drive, Vaughan, ON L6A 1T1 www.vaughan.ca




HERITAGE CLEARANCE

2021

Application Date:	
Day Month Year	
Subject Property Address (Street # and Name)	
10503 ISLIHUTAN WE.	
Lot No. Concession No.	Registered Plan Draft Plan of Subdivision (if applicable) Number (if applicable)
-/	11
	e property (demolition, grading or topsoil removal, addition,
alteration to Designated property, etc.)	DSMETIC LEASE HUD
IMPROVEMENTS, NEW MECHANICA	L system.
Property Owner Name	Applicant or Representative Name
2508819 OHTARIO IHC.	(if other than the owner) ITAY SOSHVA
Mailing Address L7E - 4E3	Mailing Address 10 ELIZABETH ST. N.
91 PARK BLVD. BOLTON, ON	RICHMOND HILL, ON L4C-4N3
Telephone	Telephone
416) 274 3608	4161 508 1590
Email	Email Company of the Advance of Company
***************************************	ITAY @ JOSHUADESIGN CO. COM
The subject parcel of land may lie in an area identified as being of high archaeological potential in the City's database of archaeological resources. The owner is advised that the following standard clauses apply:	THIS APPROVAL WAS ISSUED DURING THE EMERGENCY AND CIVIL PROTECTION ACT, IMPLEMENTED ON 20 MARCH 2020, ONTARIO.
Should archaeological resources be found on the property during	▼VAUGHAN HERITAGE APPROVAL
construction activities, all work must cease, and both the Ontario Ministry	THIS APPROVAL IS ISSUED ON THE CONDITION THAT THE WORKS SHALL BE
of Tourism, Culture and Sport and the City of Vaughan's Planning Department, Urban Design and Cultural Heritage Division shall be notified immediately.	COMPLETED WITHIN THE PROPERTY OR LANDS DESCRIBED HEREIN AS IDENTIFIED ON THIS DOCUMENT AS FILED WITH THE URBAN DESIGN AND CULTURAL HERITAGE DIVISION, DEVELOPMENT PLANNING DEPARTMENT, CITY OF VAUGHAN.
If human remains are encountered during construction activities, the	ANY CHANGES TO THIS APPROVED PLAN REQUIRES A REVISION OF THIS
proponent must immediately cease all construction activities and shall contact the York Regional Police Department, the Regional Coroner and the Registrar of the Cemeteries at the Ministry of Consumer Services.	APPROVAL BY RESUBMISSION TO CULTURAL HERITAGE AS AUTHORIZED BY HERITAGE VAUGHAN COMMITTEE.
This Heritage Clearance is valid for a period of three (3) years following the date of issuance.	05 FEBRUARY 2021
Approvals for alterations and demolitions under the OHA attach to the	HERITAGE NO LIEDITAGE BERNIT NEGECCARY
Owner, not the property.	PERMIT NO HERITAGE PERMIT NECESSARY
	HERITAGE APPROVED BY:

ADDITIONAL NOTES:

HERITAGE CLEARANCE FOR MAINTENANCE / REPLACEMENT OF DOOR/WINDOW COMBINATION AS SHOWN IN PHOTOS

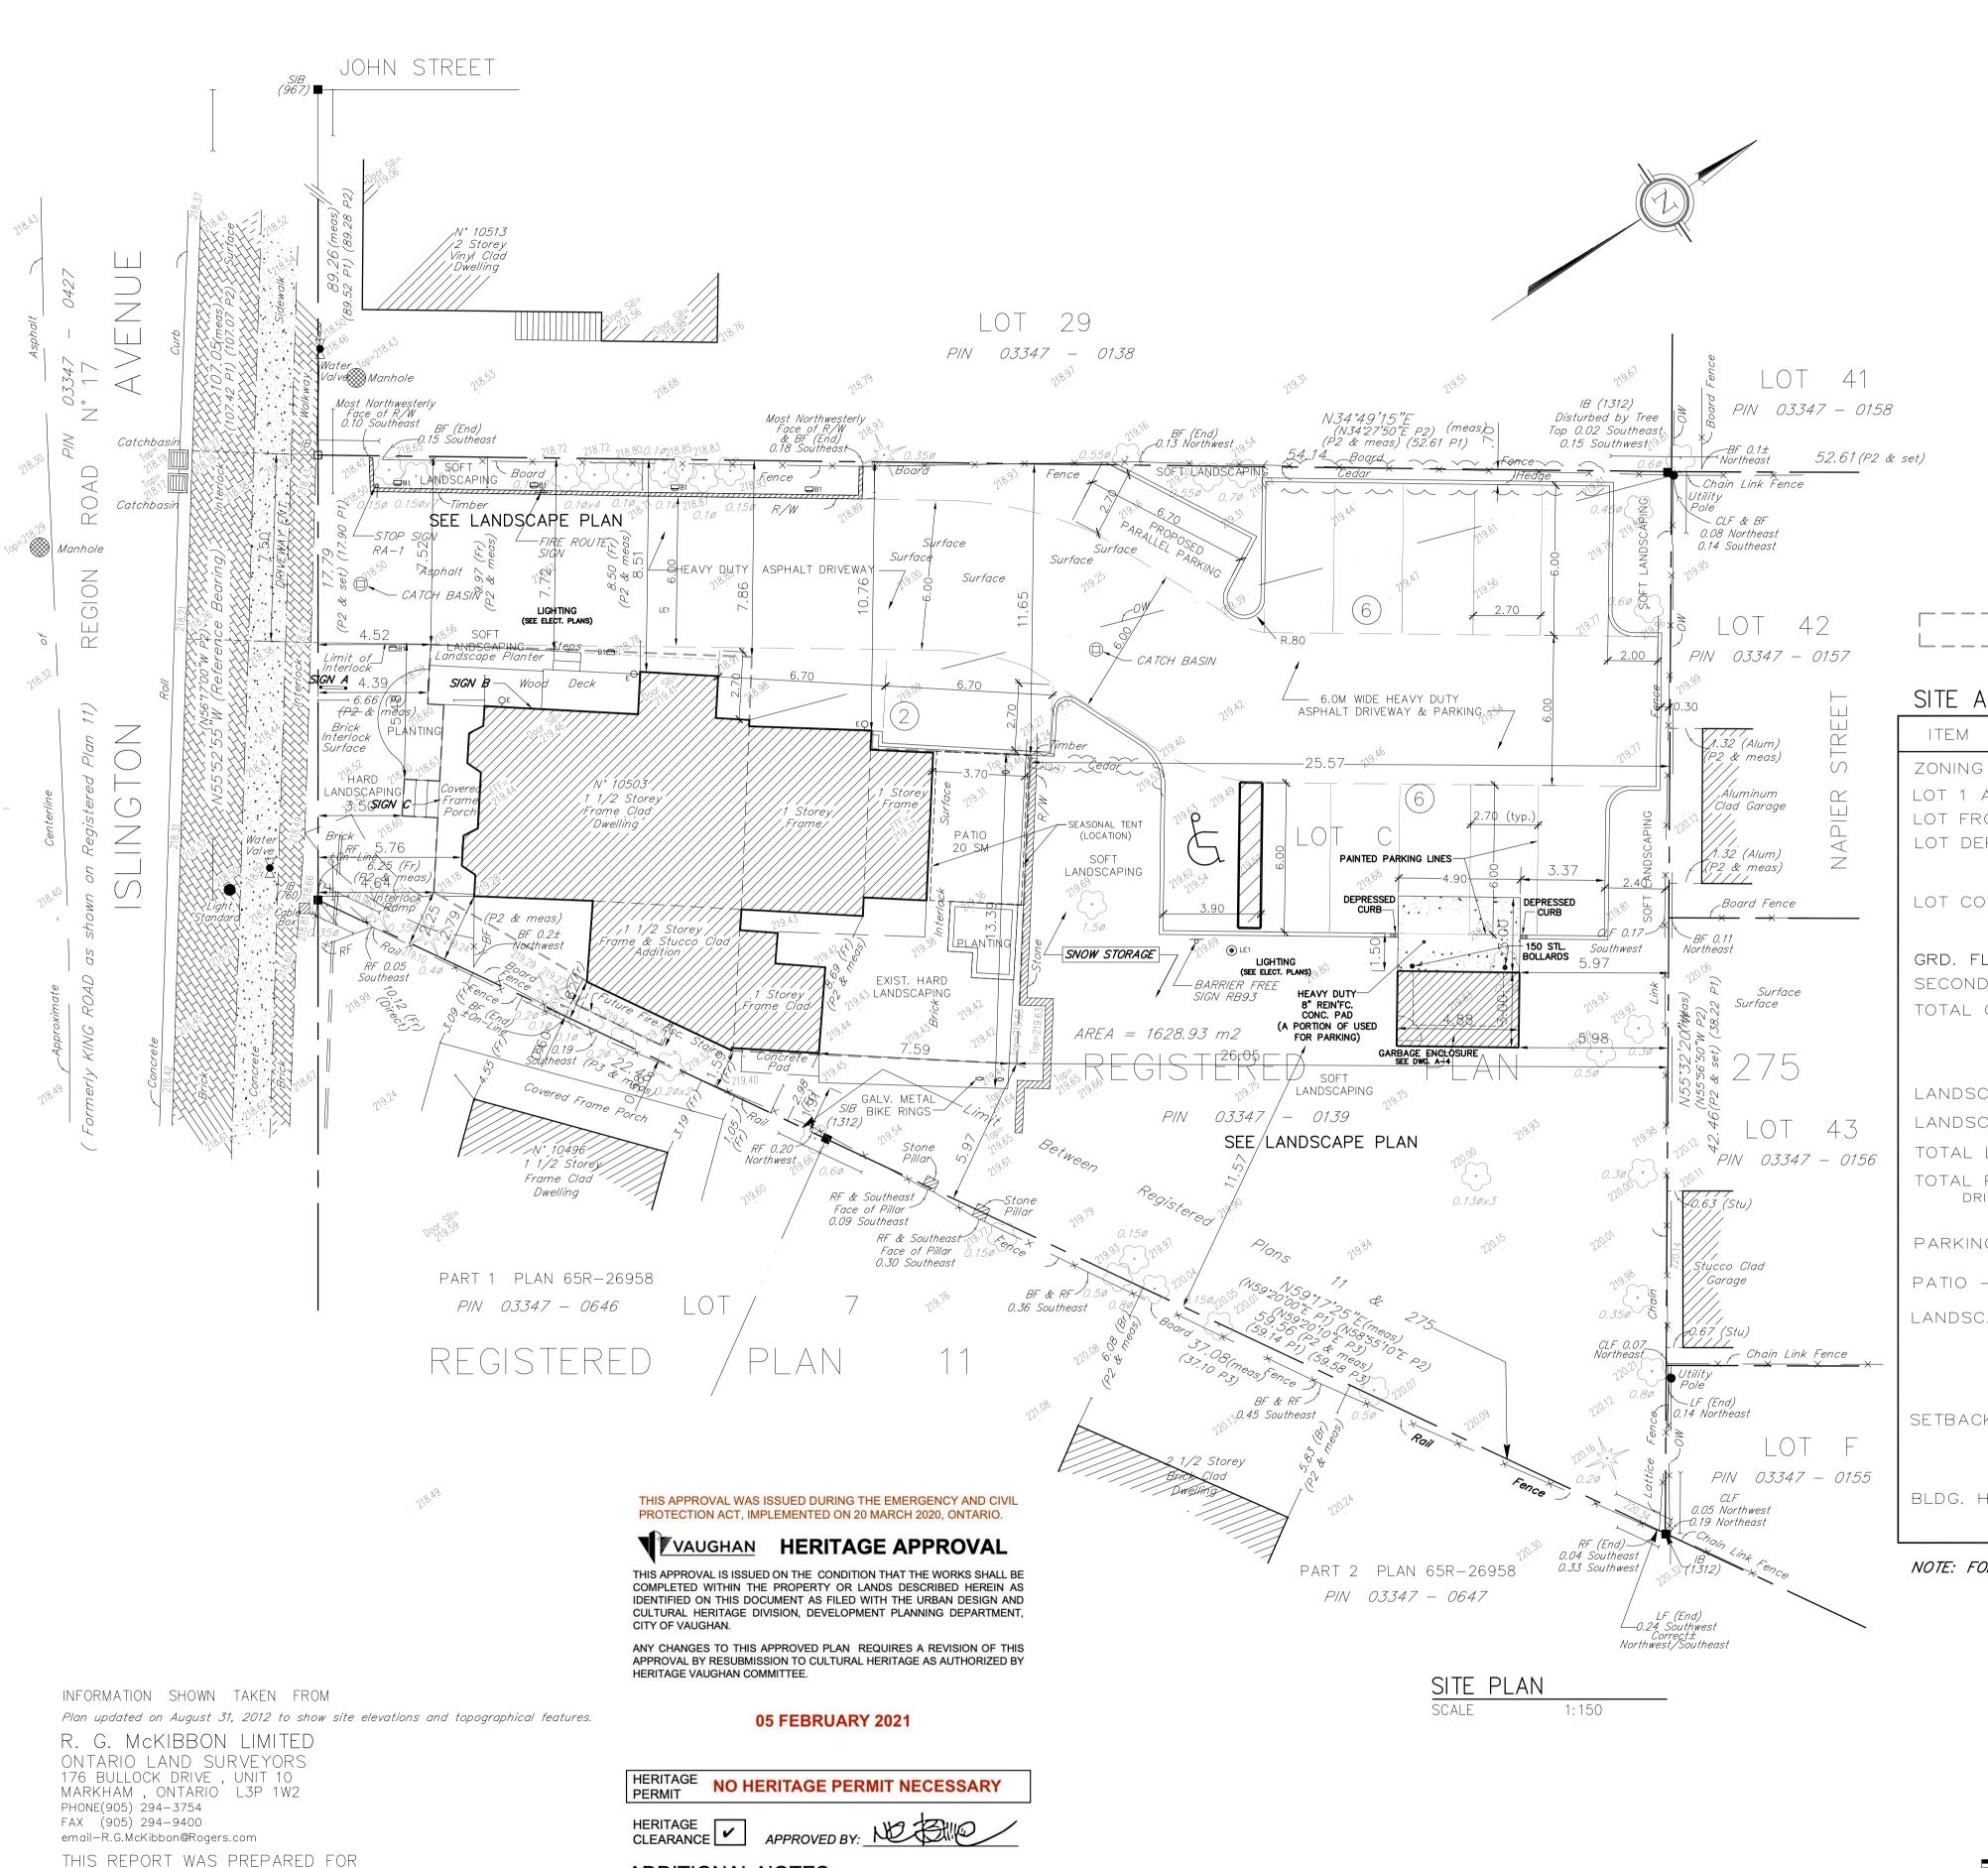


ADDITIONAL NOTES:

HERITAGE CLEARANCE FOR MAINTENANCE / REPLACEMENT

OF DOOR/WINDOW COMBINATION AS SHOWN IN PHOTOS

TONY GHAZARIAN

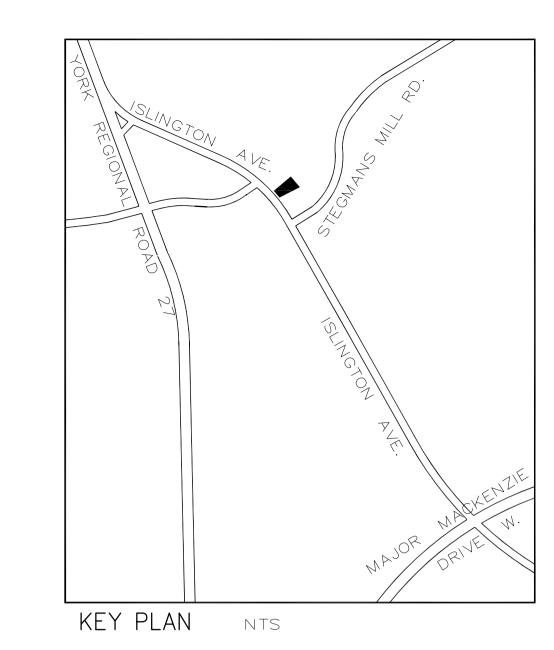


DENOTES BUILDING ENVELOPE

SITE ANALYSIS


SITE ANALYSIS		
ITEM	EXISTING	PROPOSED
ZONING	C11-9(132)	C11-9(XX)
LOT 1 AREA	1629.00 SM	no change
LOT FRONTAGE	17.79 M	no change
LOT DEPTH	54.14 M	NO CHANGE
LOT COVERAGE	179.20 SM(11.00%)	NO CHANGE
GRD. FLOOR AREA	179.20 SM	NO CHANGE
SECOND FLOOR AREA	82.87 SM	NO CHANGE
TOTAL GROSS FLOOR AREA	262.07 SM	NO CHANGE
LANDSCAPE AREA (SOFT)	690.44 SM <i>(42.39%)</i>	636.34 SM <i>(39.06%)</i>
LANDSCAPE AREA (HARD)	200.87 SM <i>(12.33%)</i>	200.87 SM <i>(12.33%)</i>
TOTAL LANDSCAPE AREA	891.31 SM <i>(54.72%)</i>	837.21 SM <i>(51.39%)</i>
TOTAL PAVED/GRAVEL AREA driveway & parking	558.49 SM <i>(34.28%)</i> asphalt & gravel	612.59 SM <i>(37.61%)</i> ASPHALT
PARKING AS PER BY-LAW 1-88,s9(132)	11 SPACES	14 SPACES
PATIO – AREA	20 SM	20 SM
LANDSCAPING — ABUTTING STREET — ABUTTING RESID. — OTHER	2.1 M(REAR YD.)	1.0 M(N SIDE YD.)
SETBACKS — FRONT YARD — REAR YARD — SIDE YARD	5.76 M 29.47 M 1.59 M / 8.51 M	NO CHANGE NO CHANGE NO CHANGE
BLDG. HEIGHT	7.48 M to peak of roof	NO CHANGE


NOTE: FOR SIGNAGE DETAILS SEE DRAWING A-3

TOTAL SITE AREA	1629.00 SM	100.00 %
TOTAL SOFT	636.34 SM	39.06 %
TOTAL HARD	200.87 SM	12.33 %
TOTAL PAVED	612.59 SM	37.61 %
FOOTPRINT	179.20 SM	11.00 %

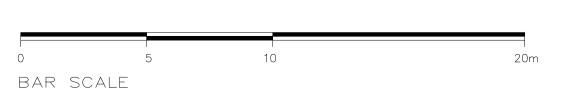

GENERAL NOTES ALL DRAWINGS ARE THE PROPERTY OF THE DESIGNER AND THEY ARE NOT TO BE REPRODUCED IN WHOLE OR IN PART WITHOUT WRITTEN CONSENT FROM THE CONTRACTOR TO CHECK AND VERIFY ALL DIMENSIONS BEFORE COMMENCING WORK AND TO REPORT ANY DISCREPANCIES TO THE DESIGNER. DO NOT SCALE DRAWINGS. ALL CONSTRUCTION TO BE ACCORDING TO BEST COMMON PRACTICE AND CONFORM TO THE ONTARIO BUILDING CODE.

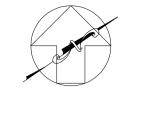

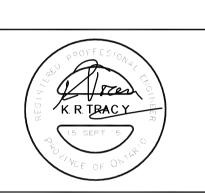

9			
8	FOR SUBMISSION	SEPT	16/15
7	BUILDING ENVELOPE DIMENSIONED ADJACENT FENCE OPENING CLOSED	AUG	31/15
6	SETBACK DIMENSIONS / PARKING LINES ADDED	MAY	07/15
5	SEASONAL TENT	MAR	10/15
4	PLANTER / BIKE RACK/ FENCE REV.	NOV	17/14
3	SIGNAGE REVISED SEE PLANS/ELEV	NOV	14/14
2	LIGHTING POST/FIXTURE/POLE	APR	29/14
1	SITE PLAN RESUBMISSION	APR	14/14
ТО	REVISION / ISSUE	D	ATE

47 Loweswater Ave. Unionville, Ontario, L3R 7W8 napadesign@rogers.com 416 930-6337

10503 ISLINGTON AVENUE Kleinburg, Ontario

> MR. & MRS. GHAZARIAN 416 297 5526 416 407 4372

DRAWING	
SITE	PLAN
DDAMAL	DDO IFOT NO
DRAWN NAPA	PROJECT NO 12-1228
DATE SEPT/12	PAGE NO
SCALE 1:150	$\neg \land 1$
CHECKED L.P.	OF



2 East 1/4" = 1'-0"

The undersigned has reviewed and takes responsibility for this design, and has the

Required unless design is exempt under Section 3.2 of Division C of the building

-ALL DRAWINGS ARE THE PROPERTY OF DESIGNER AND THEY ARE NOT TO BE REPRODUCED IN WHOLE OR CONSENT FROM THE DESIGNER. VERIFY ALL DIMENSIONS BEFORE REPORT ANY DISCREPANCIES TO ACCORDING TO BEST COMMON PRACTICE AND CONFORM TO THE

No.	Description	Date

Jan-18-2021

A5 Sheet No. 1/4" = 1'-0"

Scale



1 North 3/16" = 1'-0"

2 South 1/4" = 1'-0"



HOSSEINI HOMES CORPORATION www.hosseinihomes.com (416)200-3080 (416)720-6673

The undersigned has reviewed and takes responsibility for this design, and has the qualifications and meets the requirements set out in the Ontario Building Code to be a designer.

Registration Information
Name.HOSSEINI HOMES
CORPORATION BCIN #..42169
Required unless design is exempt under
Section 3.2 of Division C of the building
code 2006.

General Notes

-ALL DRAWINGS ARE THE PROPERTY OF DESIGNER AND THEY ARE NOT TO BE REPRODUCED IN WHOLE OR IN PART WITHOUT WRITTEN CONSENT FROM THE DESIGNER.
-CONTRACTOR TO CHECK AND VERIFY ALL DIMENSIONS BEFORE COMMENCING WORK AND TO REPORT ANY DISCREPANCIES TO THE DESIGNER.
-DO NOT SCALE DRAWINGS.
-ALL CONSTRUCTION TO BE ACCORDING TO BEST COMMON PRACTICE AND CONFORM TO THE ONTARIO BUILDING CODE.

Description	Date
	Description

10503 Islington Ave.


Klienburg

Sheet Name:

Elevations As Built

Issue Date:
Plot Date:
July-30-2020
Jan-18-2021

Sheet No. A6
Scale As indicated

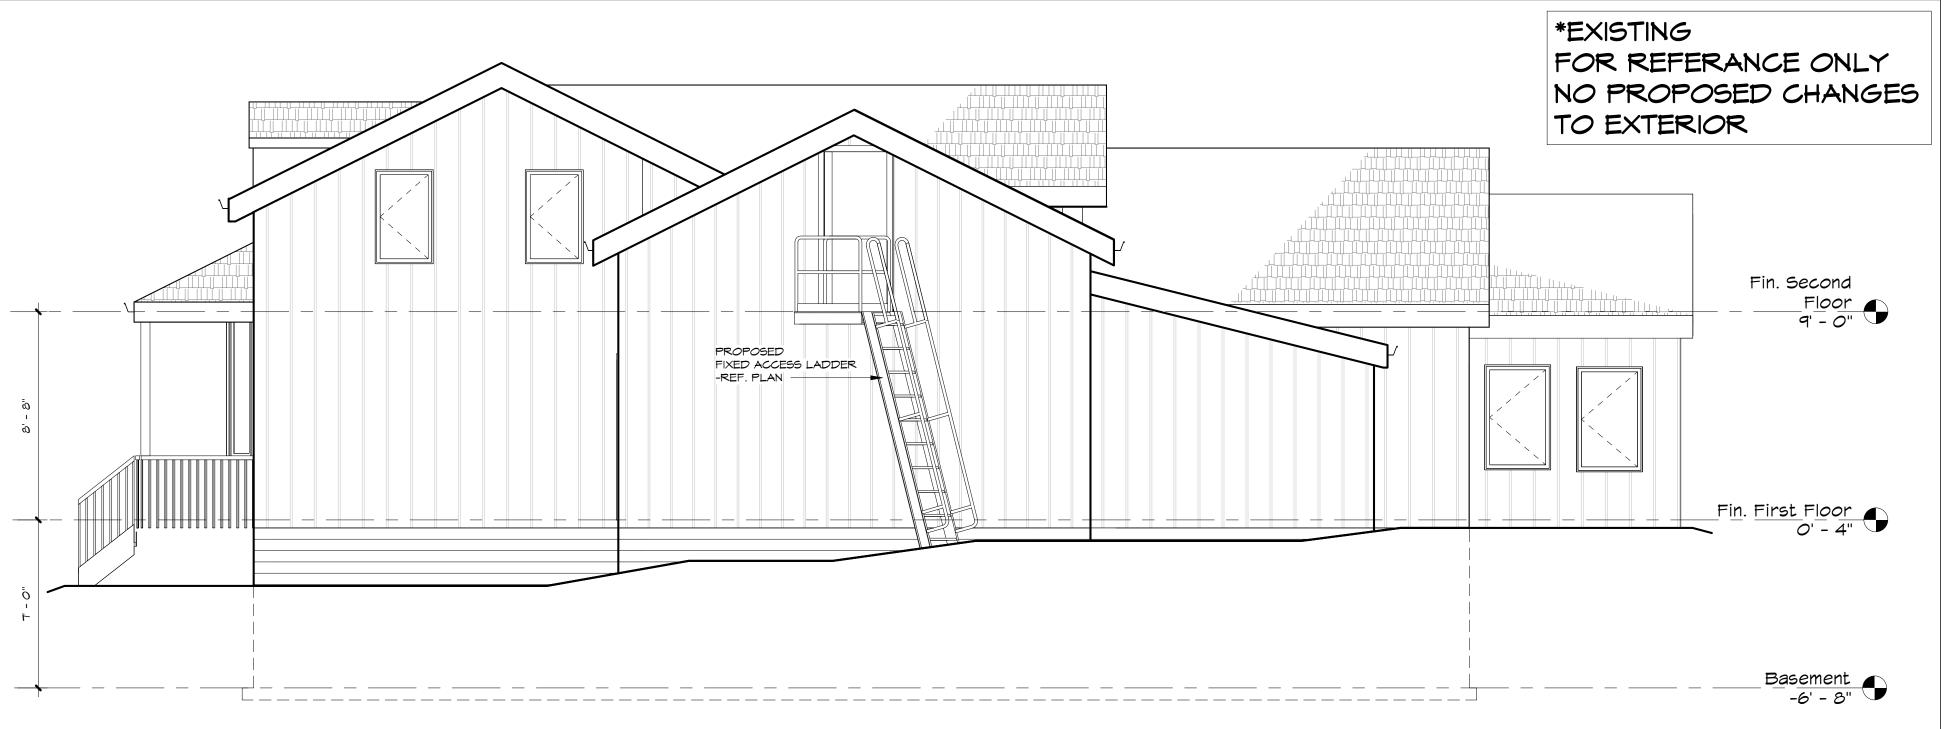



NORTH ELEVATION

EXISTING DOOR

NEW SERVICE LADDER TO EXIST. DOOR (OUT OF STREETVIEW)

TO BE INFILLED AND CLADDED M/ BOARD AND BATTON TO MATCH EXISTING

THIS APPROVAL WAS ISSUED DURING THE EMERGENCY AND CIVIL PROTECTION ACT, IMPLEMENTED ON 20 MARCH 2020, ONTARIO.

VAUGHAN HERITAGE APPROVAL


TO APPROVAL IS ISSUED ON THE CONDITION THAT THE WORKS SHALL BE COMPLETED WITHIN THE PROPERTY OR LANDS DESCRIBED HEREIN AS IDENTIFIED ON THIS DOCUMENT AS FILED WITH THE URBAN DESIGN AND CULTURAL HERITAGE DIVISION, DEVELOPMENT PLANNING DEPARTMENT, CITY OF VAUGHAN.

ANY CHANGES TO THIS APPROVED PLAN REQUIRES A REVISION OF THIS APPROVAL BY RESUBMISSION TO CULTURAL HERITAGE AS AUTHORIZED BY HERITAGE VAUGHAN COMMITTEE.

05 FEBRUARY 2021

NO HERITAGE PERMIT NECESSARY



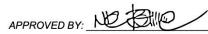

ADDITIONAL NOTES:


HERITAGE CLEARANCE FOR MAINTENANCE / REPLACEMENT OF DOOR/WINDOW COMBINATION AS SHOWN IN PHOTOS



SOUTH ELEVATION

THESE WINDOWS AND DOOR WILL BE REPLACED BY A SLIDING GLASS DOOR. HEIGHT AND WIDTH OF EXISTING OPENING TO REMAIN UNCHANGED

(REF. EAST ELEVATION, SHEET A5)

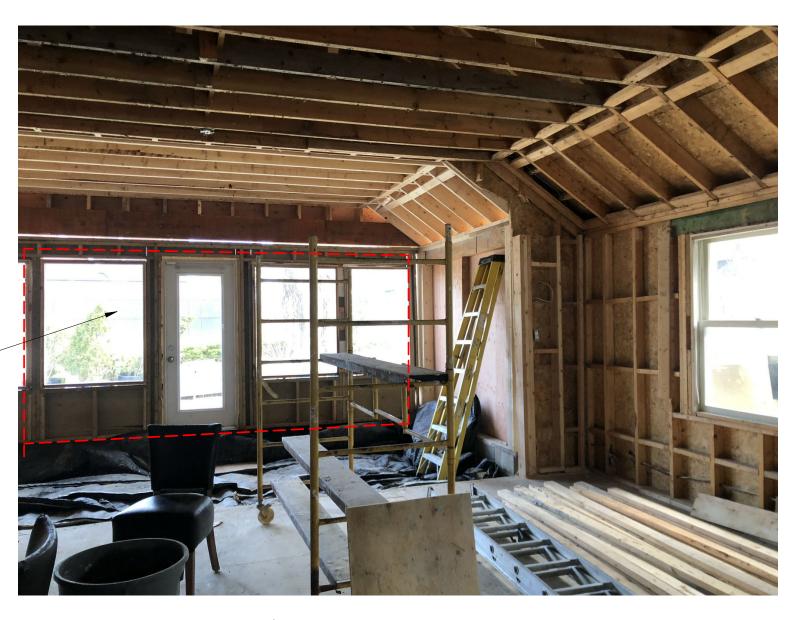

INSIDE LOOKING OUT (EAST)

THIS APPROVAL WAS ISSUED DURING THE EMERGENCY AND CIVIL PROTECTION ACT, IMPLEMENTED ON 20 MARCH 2020, ONTARIO.




THIS APPROVAL IS ISSUED ON THE CONDITION THAT THE WORKS SHALL BE COMPLETED WITHIN THE PROPERTY OR LANDS DESCRIBED HEREIN AS IDENTIFIED ON THIS DOCUMENT AS FILED WITH THE URBAN DESIGN AND CULTURAL HERITAGE DIVISION, DEVELOPMENT PLANNING DEPARTMENT,

ANY CHANGES TO THIS APPROVED PLAN REQUIRES A REVISION OF THIS APPROVAL BY RESUBMISSION TO CULTURAL HERITAGE AS AUTHORIZED BY HERITAGE VAUGHAN COMMITTEE.

05 FEBRUARY 2021

HERITAGE PERMIT NECESSARY
PERMIT

HERITAGE CLEARANCE

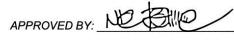

ADDITIONAL NOTES:

HERITAGE CLEARANCE FOR MAINTENANCE / REPLACEMENT OF DOOR/WINDOW COMBINATION AS SHOWN IN PHOTOS